

CF

USE TYPEWRITER OR BALL POINT PEN-PRESS FIRMLY, PRINT CLEARLY.

T R EW sec 1/4 1/4 1/4 No.


WATER WELL RECORD  
KSA 82a-1201-1215

Kansas State Dept. Of Health  
(Water Well Contractors)  
Forbes-Bldg. 740  
Topeka, Kansas 66620

NW SW NE

1 Location of well:	County <i>Marshall</i>	Township name <i>Waterville</i>	Fraction <i>NE 1/4 SW 1/4 NW 1/4</i>	Section number <i>23</i>	Town number <i>4</i>	Range number <i>6 E</i>
---------------------	---------------------------	------------------------------------	---	-----------------------------	-------------------------	----------------------------

Distance and direction from nearest town or city:	3 Owner of well: <i>Jerry Hedke</i>
Street address of well location if in city:	Address: <i>R.F.D. 1 Waterville, Kans</i>

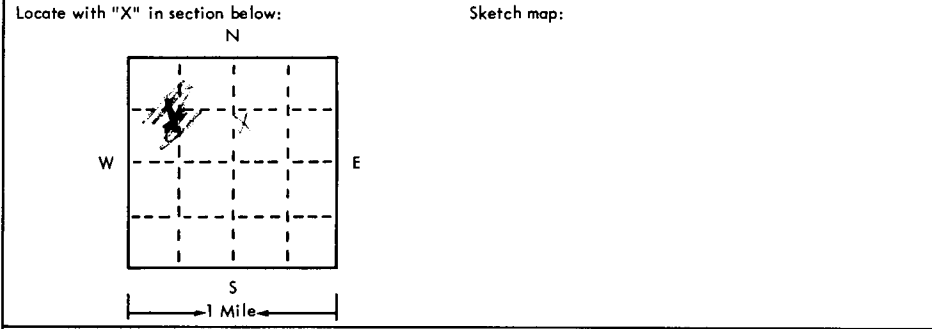

4 Well depth: <i>100</i> ft. Date of completion <i>5-9-77</i> Well diameter <i>30</i> in.
5 <input type="checkbox"/> Cable tool <input type="checkbox"/> Rotary <input type="checkbox"/> Driven <input type="checkbox"/> Dug <input type="checkbox"/> Hollow rod <input type="checkbox"/> Jetted <input type="checkbox"/> Bored <input checked="" type="checkbox"/> Reverse rotary
6 Use: <input type="checkbox"/> Domestic <input type="checkbox"/> Public supply <input type="checkbox"/> Industry <input checked="" type="checkbox"/> Irrigation <input type="checkbox"/> Air conditioning <input type="checkbox"/> Commercial <input type="checkbox"/> Test well
7 Casing: Material <i>iron</i> Height: <i>100</i> Threaded <input type="checkbox"/> Welded <input type="checkbox"/> Surface <i>12</i> in. Diam. <i>banded</i> Weight <i>25</i> lbs./ft. <i>16</i> in. to <i>100</i> ft. depth Drive shoe? <input type="checkbox"/> Yes <input type="checkbox"/> No

2	Type and color of material	From	To
	<i>Top soil</i>	<i>0</i>	<i>3</i>
	<i>Brown clay</i>	<i>3</i>	<i>10</i>
	<i>Red clay</i>	<i>10</i>	<i>34</i>
	<i>fine Red sand</i>	<i>34</i>	<i>40</i>
	<i>medium course sand</i>	<i>40</i>	<i>63</i>
	<i>Brown clay</i>	<i>63</i>	<i>70</i>
	<i>course sand &amp; gravel</i>	<i>70</i>	<i>102</i>
	<i>Shale</i>	<i>102</i>	

8 Screen: Manufacturer <i>Johnson Irrigator</i> Type _____ Dia. <i>1 1/2"</i> Slot/size <i>100</i> Length <i>7.5</i> Set between <i>85</i> ft. and <i>100</i> ft. Fittings: _____ Gravel pack <input checked="" type="checkbox"/> Yes <input type="checkbox"/> No Size range of material <i>1/8 to 1/4"</i>
9 Static water level: <i>70</i> ft. below land surface Date <i>5-9-77</i>
10 Pumping level below land surfaces: _____ ft. after _____ hrs. pumping _____ g.p.m. _____ ft. after _____ hrs. pumping _____ g.p.m. Estimated maximum yield _____ g.p.m.
11 Water sample submitted: <input type="checkbox"/> Yes <input type="checkbox"/> No Date _____
12 Well head completion: <input type="checkbox"/> Pitless adapter <input type="checkbox"/> Inches above grade
13 Well grouted? <input checked="" type="checkbox"/> Yes <input type="checkbox"/> No <input checked="" type="checkbox"/> Neat cement <input type="checkbox"/> Bentonite _____ Depth: From <i>6</i> ft. to <i>20</i> ft.
14 Nearest source of possible contamination: ft. <i>200</i> Direction <i>South</i> Type <i>Home</i> Well disinfected upon completion? <input checked="" type="checkbox"/> Yes <input type="checkbox"/> No
15 Pump: <input type="checkbox"/> Not installed Manufacturer's name <i>Western Land Irrigator</i> Model number <i>KBH</i> HP <i>80</i> Volts _____ Length of drop pipe <i>90</i> ft. capacity <i>800</i> g.p.m. Type: <input type="checkbox"/> Submersible <input checked="" type="checkbox"/> Turbine <input type="checkbox"/> Jet <input type="checkbox"/> Reciprocating <input type="checkbox"/> Centrifugal <input type="checkbox"/> Other

16 Remarks: elevation *1170'*

Topography:

Hill  
 Slope  
 Upland  
 Valley

17 Water well contractor's certification:  
This well was drilled under my jurisdiction and this report is true to the best of my knowledge and belief.

*Blue Valley Drilling 234*  
Business name \_\_\_\_\_ License No. \_\_\_\_\_  
Address *Blue Rapids, K.O.*  
Signed \_\_\_\_\_ Date \_\_\_\_\_  
Authorized representative

Forward the white, blue and pink copies to the Kansas State Dept. Of Health.

Form WWC-5

H  
CE  
23  
NE SW NW