


1 LOCATION OF WATER WELL:	Fraction	Section Number	Township Number	Range Number
County: Marshall	NE 1/4 SE 1/4 SW 1/4	20	T 4 S	R 7 EW

Distance and direction from nearest town or city street address of well if located within city?
 On the downward side of the Blue River Levee

2 WATER WELL OWNER: Department of the Army - Corps of Engineers
 Fort Riley Resident Office
 RR#, St. Address, Box #: P.O. Box 2189
 City, State, ZIP Code: Fort Riley, KS 66442
 Board of Agriculture, Division of Water Resources
 Application Number:

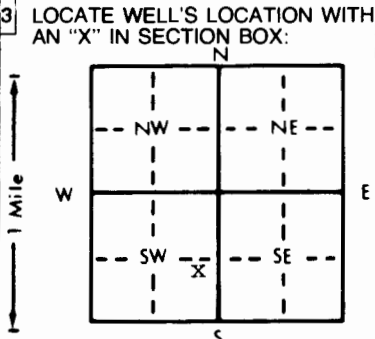

4 DEPTH OF COMPLETED WELL: 36 ft. ELEVATION: 1110.33

Depth(s) Groundwater Encountered 1. ft. 2. ft. 3. ft.

WELL'S STATIC WATER LEVEL 3 ft. below land surface measured on mo/day/yr

Pump test data: Well water was not ch'd ft. after hours pumping gpm

Est. Yield unknown gpm: Well water was ft. after hours pumping gpm

Bore Hole Diameter: 24 1/2 in. to 10 ft., and 18 in. to 36.4 ft.

WELL WATER TO BE USED AS:

5 Public water supply	8 Air conditioning	11 Injection well
1 Domestic	3 Feedlot	6 Oil field water supply
2 Irrigation	4 Industrial	7 Lawn and garden only
		9 Dewatering
		10 Monitoring well
		12 Other (Specify below)
		Relief Well

Was a chemical/bacteriological sample submitted to Department? Yes No X; If yes, mo/day/yr sample was submitted

Water Well Disinfected? Yes X No

5 TYPE OF BLANK CASING USED:

1 Steel	3 RMP (SR)	6 Asbestos-Cement	9 Other (specify below)	Welded X
2 PVC	4 ABS	7 Fiberglass	Stainless steel	Threaded

Blank casing diameter 8 5/8 in. to 23.5 ft., Dia in. to ft., Dia in. to ft.

Casing height above land surface 6 in., weight 28.55 lbs./ft. Wall thickness or gauge No. 322

TYPE OF SCREEN OR PERFORATION MATERIAL:

1 Steel	3 Stainless steel	5 Fiberglass	8 RMP (SR)	11 Other (specify)
2 Brass	4 Galvanized steel	6 Concrete tile	9 ABS	12 None used (open hole)

SCREEN OR PERFORATION OPENINGS ARE:

1 Continuous slot	3 Mill slot	5 Gauzed wrapped	8 Saw cut	11 None (open hole)
2 Louvered shutter	4 Key punched	6 Wire wrapped	9 Drilled holes	
		7 Torch cut	10 Other (specify)	

SCREEN-PERFORATED INTERVALS: From 23.5 ft. to 35.5 ft., From ft. to ft.

GRAVEL PACK INTERVALS: From 8 ft. to 10 ft., From ft. to ft.

From 10 ft. to 36.4 ft., From ft. to ft.

6 GROUT MATERIAL: 1 Neat cement 2 Cement grout 3 Bentonite 4 Other

Grout Intervals: From 1.5 ft. to 8 ft., From 0 ft. to 1.5 ft., From ft. to ft.

What is the nearest source of possible contamination:

1 Septic tank	4 Lateral lines	7 Pit privy	10 Livestock pens	14 Abandoned water well
2 Sewer lines	5 Cess pool	8 Sewage lagoon	11 Fuel storage	15 Oil well/Gas well
3 Watertight sewer lines	6 Seepage pit	9 Feedyard	12 Fertilizer storage	16 Other (specify below)
			13 Insecticide storage	None known

Direction from well? How many feet?

FROM	TO	LITHOLOGIC LOG	FROM	TO	PLUGGING INTERVALS
0	3.5	Clay, silty with sand and gravel			
3.5	15	Clay			
15	20	Clay with silty bands			
20	23	Sand			
23	26	Clay			
26	31	Sand, medium			
31	36	Sand and cobble			
36	36.4	Bedrock			

7 CONTRACTOR'S OR LANDOWNER'S CERTIFICATION: This water well was (1) constructed, (2) reconstructed, or (3) plugged under my jurisdiction and was completed on (mo/day/year) 10-14-96 and this record is true to the best of my knowledge and belief. Kansas Water Well Contractor's License No. 185 This Water Well Record was completed on (mo/day/yr) 11-12-96 under the business name of Clarke Well & Equipment, Inc. by (signature) *Clarke Well & Equipment*

OFFICE USE ONLY
T
R
EW
SEC.
1/4
1/4
1/4