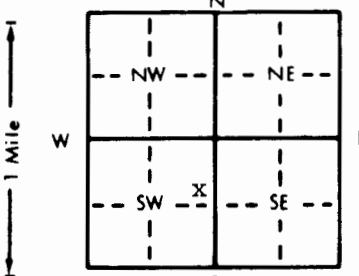


1 LOCATION OF WATER WELL: County: Marshall	Fraction SE 1/4 NE 1/4 SW 1/4	Section Number 20	Township Number T 4 S	Range Number R 7 E/W
--	---	-----------------------------	---------------------------------	--------------------------------

Distance and direction from nearest town or city street address of well if located within city?
On the downward side of the Blue River Levee

2 WATER WELL OWNER: RR#, St. Address, Box # : City, State, ZIP Code :	Department of the Army - Corps of Engineers Fort Riley Resident Office P.O. Box 2189 Fort Riley, KS 66442	Board of Agriculture, Division of Water Resources Application Number:
---	--	--

3 LOCATE WELL'S LOCATION WITH AN "X" IN SECTION BOX: 	4 DEPTH OF COMPLETED WELL: 37.31 ft. ELEVATION: 1110.03 Depth(s) Groundwater Encountered 1. ft. 2. ft. 3. ft. WELL'S STATIC WATER LEVEL 6 ft. below land surface measured on mo/day/yr Pump test data: Well water was not ch'd ft. after hours pumping gpm Est. Yield unknown gpm: Well water was ft. after hours pumping gpm Bore Hole Diameter: 24 1/2 in. to 10 ft., and 18 in. to 38 ft. WELL WATER TO BE USED AS: 5 Public water supply 8 Air conditioning 11 Injection well 1 Domestic 3 Feedlot 6 Oil field water supply 9 Dewatering 12 Other (Specify below) 2 Irrigation 4 Industrial 7 Lawn and garden only 10 Monitoring well Relief Well Was a chemical/bacteriological sample submitted to Department? Yes No <input checked="" type="checkbox"/> X; If yes, mo/day/yr sample was submitted Water Well Disinfected? Yes <input checked="" type="checkbox"/> No
--	--

5 TYPE OF BLANK CASING USED: 1 Steel 3 RMP (SR) 5 Wrought iron 8 Concrete tile 2 PVC 4 ABS 6 Asbestos-Cement 9 Other (specify below) 7 Fiberglass Stainless steel	CASING JOINTS: Glued Clamped Welded <input checked="" type="checkbox"/> Threaded
Blank casing diameter 8.5/8 in. to 22.81 ft., Dia in. to ft., Dia in. to ft. Casing height above land surface 6 in., weight 28.55 lbs./ft. Wall thickness or gauge No. 322	
TYPE OF SCREEN OR PERFORATION MATERIAL: 1 Steel 3 <u>Stainless steel</u> 5 Fiberglass 8 RMP (SR) 10 Asbestos-cement 2 Brass 4 Galvanized steel 6 Concrete tile 9 ABS 11 Other (specify) 12 None used (open hole)	SCREEN OR PERFORATION OPENINGS ARE: 1 <u>Continuous slot</u> 3 Mill slot 5 Gauzed wrapped 8 Saw cut 11 None (open hole) 2 Louvered shutter 4 Key punched 6 Wire wrapped 9 Drilled holes 7 Torch cut 10 Other (specify)
SCREEN-PERFORATED INTERVALS: From 22.81 ft. to 36.81 ft., From ft. to ft. From ft. to ft., From ft. to ft.	
GRAVEL PACK INTERVALS: From 8 ft. to 10 ft., From ft. to ft. From 10 ft. to 38 ft., From ft. to ft.	

6 GROUT MATERIAL: 1 <u>Neat cement</u> 2 <u>Cement grout</u> 3 Bentonite 4 Other	Grout Intervals: From 1.5 ft. to 8 ft., From 0 ft. to 1.5 ft., From ft. to ft.
What is the nearest source of possible contamination: 1 Septic tank 4 Lateral lines 7 Pit privy 10 Livestock pens 14 Abandoned water well 2 Sewer lines 5 Cess pool 8 Sewage lagoon 11 Fuel storage 15 Oil well/Gas well 3 Watertight sewer lines 6 Seepage pit 9 Feedyard 12 Fertilizer storage 16 Other (specify below) 13 Insecticide storage None known	
Direction from well? How many feet?	

FROM	TO	LITHOLOGIC LOG	FROM	TO	PLUGGING INTERVALS
0	11	Clay			
11	20	Sand with clay			
20	23	Sand			
23	25	Sand and gravel			
25	37	Sand and gravel with large cobble			
37	38	Limestone			

7 CONTRACTOR'S OR LANDOWNER'S CERTIFICATION: This water well was (1) <u>constructed</u> , (2) reconstructed, or (3) plugged under my jurisdiction and was completed on (mo/day/year) 10-14-96 and this record is true to the best of my knowledge and belief. Kansas Water Well Contractor's License No. 185 This Water Well Record was completed on (mo/day/yr) 11-12-96 under the business name of Clarke Well & Equipment, Inc. by (signature) <i>Clarke Well & Equipment</i>
--

INSTRUCTIONS: Use typewriter or ball point pen. PLEASE PRESS FIRMLY and PRINT clearly. Please fill in blanks, underline or circle the correct answers. Send top three copies to Kansas Department of Health and Environment, Bureau of Water, Topeka, Kansas 66620-0001. Telephone: 913-296-5545. Send one to WATER WELL OWNER and retain one for your records.

OFFICE USE ONLY
T
R
EW
SEC.
1/4
1/4
1/4