WATER WELL RECORD Form WWC-5 KSA 82a-1212

1 LOCATION OF WATER WELL: County: Marshall Co. | Fraction: SW ¼ NW ¼ NW ¼ | Section Number: 21 | Township Number: T 4 S | Range Number: R 7 E W

Distance and direction from nearest town or city street address of well if located within city? 6o Imiles North West of Blue Rapids, KS

2 WATER WELL OWNER: Georgia Pacific Corp.
RR#, St. Address, Box # : P.O. Box 187
City, State, ZIP Code : Blue Rapids, KS 66411

Board of Agriculture, Division of Water Resources
Application Number:

3 LOCATE WELL'S LOCATION WITH AN "X" IN SECTION BOX:

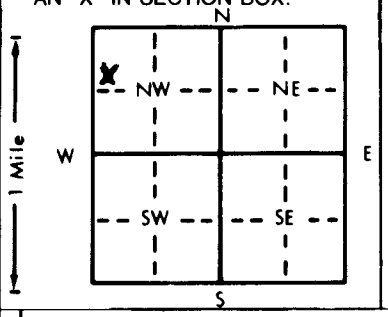

4 DEPTH OF COMPLETED WELL 36' (WDS) ft. ELEVATION:
Depth(s) Groundwater Encountered 1. 20' (WDS) ft. 2. ft. 3. ft.
WELL'S STATIC WATER LEVEL 17' (WDS) ft. below land surface measured on mo/day/yr
Pump test data: Well water was ft. after hours pumping gpm
Est. Yield 2.00 gpm: Well water was ft. after hours pumping gpm
Bore Hole Diameter ? in. to ft., and in. to ft.
WELL WATER TO BE USED AS: 5 Public water supply 8 Air conditioning 11 Injection well
1 Domestic 3 Feedlot 6 Oil field water supply 9 Dewatering 12 Other (Specify below)
2 Irrigation (4) Industrial 7 Lawn and garden only 10 Monitoring well
Was a chemical/bacteriological sample submitted to Department? Yes No; If yes, mo/day/yr sample was submitted
Water Well Disinfected? (Yes) No

5 TYPE OF BLANK CASING USED: 5 Wrought iron 8 Concrete tile CASING JOINTS: Glued Clamped
(1 Steel) (WDS) 3 RMP (SR) 6 Asbestos-Cement 9 Other (specify below) Welded
2 PVC 4 ABS 7 Fiberglass Threaded
Blank casing diameter WDS 12" in. to ft. Dia in. to ft., Dia in. to ft.
Casing height above land surface CUT OFF 3' BELOW GRADE in., weight lbs./ft. Wall thickness or gauge No.

TYPE OF SCREEN OR PERFORATION MATERIAL: 7 PVC 10 Asbestos-cement
1 Steel 3 Stainless steel 5 Fiberglass 8 RMP (SR) 11 Other (specify)
2 Brass 4 Galvanized steel 6 Concrete tile 9 ABS 12 None used (open hole)

SCREEN OR PERFORATION OPENINGS ARE: 5 Gauzed wrapped 8 Saw cut 11 None (open hole)
1 Continuous slot 3 Mill slot 6 Wire wrapped 9 Drilled holes
2 Louvered shutter 4 Key punched ? 7 Torch cut 10 Other (specify)

SCREEN-PERFORATED INTERVALS: From ? ft. to ft., From ft. to ft.
From ft. to ft., From ft. to ft.
GRAVEL PACK INTERVALS: From ft. to ft., From ft. to ft.
From ft. to ft., From ft. to ft.

6 GROUT MATERIAL: 1 Neat cement 2 Cement grout (3 Bentonite) 4 Other
Grout Intervals: From 3 ft. to 20 ft., From ft. to Envirosplug From ft. to ft.

What is the nearest source of possible contamination: None Close
10 Livestock pens 14 Abandoned water well
1 Septic tank 4 Lateral lines 7 Pit privy 11 Fuel storage 15 Oil well/Gas well
2 Sewer lines 5 Cess pool 8 Sewage lagoon 12 Fertilizer storage 16 Other (specify below)
3 Watertight sewer lines 6 Seepage pit 9 Feedyard 13 Insecticide storage
Direction from well? How many feet?

FROM	TO	LITHOLOGIC LOG	FROM	TO	PLUGGING INTERVALS
20	36	Clorinated Sands & Gravels			
3	20	Envirosplug			
0	3	Compacted Clays			
		plugged			

7 CONTRACTOR'S OR LANDOWNER'S CERTIFICATION: This water well was (1) constructed, (2) reconstructed, or (3) plugged under my jurisdiction and was completed on (mo/day/year) 9/24/90 and this record is true to the best of my knowledge and belief. Kansas Water Well Contractor's License No. 45 This Water Well Record was completed on (mo/day/yr) 10/2/90
under the business name of Haas Lime Well Drilling by (signature) Craig Haas CWD/RT

INSTRUCTIONS: Use typewriter or ball point pen. *PLEASE PRESS FIRMLY* and *PRINT* clearly. Please fill in blanks, underline or circle the correct answers. Send top three copies to Kansas Department of Health and Environment, Bureau of Water Protection, Topeka, Kansas 66620-7320. Telephone: 913-296-5514. Send one to WATER WELL OWNER and retain one for your records.

OFFICE USE ONLY T R E/W SEC. ¼ ¼ ¼