

USE TYPEWRITER OR BALL POINT PEN-PRESS FIRMLY, PRINT CLEARLY.


WATER WELL RECORD
KSA 82-1201-1215

Kansas Department of Health and Environment-Division of Environment
(Water well Contractors)
Topeka, Kansas 66620

The east 1/2 of 1/4
Southeast 1/4 1/4 1/4

1. Location of well: County Marshall Fraction Southeast 1/4 Section number 24 Township number T 4 South Range number R 7 East

2. Distance and direction from nearest town or city: 3 miles east of Blue Rapids on highway north side road
3. Owner of well: Ted Martin
R.R. or street: Blue Rapids KS 66411
City, state, zip code:

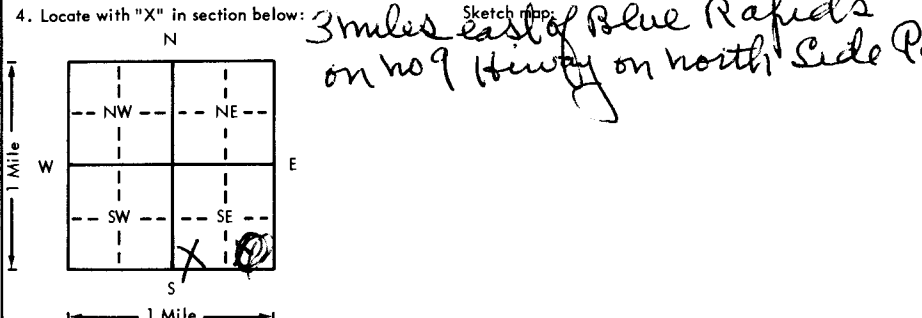

6. Bore hole dia. 10 in. Completion date 3-16-77
Well depth 90 ft.
7. Cable tool Rotary Driven Dug
 Hollow rod Jetted Bored Reverse rotary
8. Use: Domestic Public supply Industry
 Irrigation Air conditioning Stock
 Lawn Oil field water Other
9. Casing: Material PVC Height: Above or below 15' in.
Threaded Welded Surface 15' in.
RMP PVC Weight 2.58 lbs./ft.
Dia. 5 in. to 90 ft. depth Wall Thickness: sch 40 inches
Dia. 5 in. to 90 ft. depth gage No. Sch 40

5. Type and color of material	From	To
top soil Black	0	8
Clay, Brown	8	15
Rock, Limestone yellow	15	32
Rock, Limestone	32	40
Rock, Blue	40	81
Shale, Blue	81	90

10. Screen: Manufacturer's name Pumped
Type PVC Dia. 5
Slot 3/40 Length 40
Set between 30 ft. and 70 ft.
Gravel pack? Size range of material 4X 1/8
11. Static water level: 35 ft. below land surface Date 3-16-77
12. Pumping level below land surfaces:
____ ft. after ____ hrs. pumping ____ g.p.m.
____ ft. after ____ hrs. pumping ____ g.p.m.
Estimated maximum yield 2 g.p.m.
13. Water sample submitted: X Yes No Date
14. Well head completion: NA
____ Pitless adapter ____ Inches above grade
15. Well grouted?
With: Neat cement Bentonite Concrete
Depth: From 15 ft. to 0 ft.
16. Nearest source of possible contamination:
ft. 60 Direction east Type ditch
Well disinfected upon completion? Yes No
17. Pump: Not installed
Manufacturer's name _____
Model number _____ HP _____ Volts _____
Length of drop pipe _____ ft. capacity _____ g.p.m.
Type:
 Submersible Turbine
 Jet Reciprocating
 Centrifugal Other

18. Elevation: _____
19. Remarks: _____
20. Water well contractor's certification:
This well was drilled under my jurisdiction and this report is true to the best of my knowledge and belief.
Business name Strader Drilling Co 237 License No. _____
Address Blue Rapids
Signed Harold Strader Date 3-16-77
Authorized representative

T 4 S R 7 E Sec 24