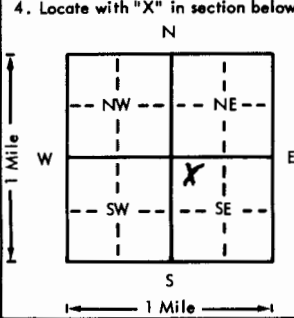


USE TYPEWRITER OR BALL POINT PEN—PRESS FIRMLY, PRINT CLEARLY.

WATER WELL RECORD  
KSA 82a-1201-1215

Kansas Department of Health and Environment—Division of Environment  
(Water well Contractors)  
Topeka, Kansas 66620

1. Location of well: County <b>Marshall</b> Fraction <b>NW 1/4 NW 1/4 SE 1/4</b> Section number <b>17</b> Township number <b>T 4 S</b> Range number <b>R 7 E</b>	
2. Distance and direction from nearest town or city: <b>1 - W. of Blue Rapids</b> Street address of well location if in city:	
3. Owner of well: <b>Frank Boller &amp; Elmer Haacker</b> R.R. <del>number</del> : <b>1</b> City, state, zip code: <b>Blue Rapids KS 66411</b>	
4. Locate with "X" in section below: Sketch map: 	
5. Type and color of material	
	From To
Dirt Black	0 2
Clay Brown	2 7
Shale "	7 10
Lime Rock-White	10 15
Shale Blue	15 20
" Brown	20 25
Lime Rock Gray	25 30
" " "	30 35
Shale Blue	35 40
" " "	4 45
Lime Rock Gray	45 50
" " "	50 55
Shale Blue	55 60
(Use a second sheet if needed)	
18. Elevation:  Topography: — Hill — Slope — Upland <input checked="" type="checkbox"/> Valley	19. Remarks:
6. Bore hole dia. <b>2</b> in. Completion date <b>6-19-76</b> Well depth <b>60</b> ft.	
7. <input checked="" type="checkbox"/> Cable tool — Rotary — Driven — Dug — Hollow rod — Jetted — Bored — Reverse rotary	
8. Use: — Domestic — Public supply — Industry — Irrigation — Air conditioning <input checked="" type="checkbox"/> Stock — Lawn — Oil field water — Other	
9. Casing: Material <b>Plst.</b> Height: <b>Above</b> or below Threaded — Welded <b>SI</b> Surface <b>12</b> in. RMP — PVC <input checked="" type="checkbox"/> Weight — lbs./ft. Dia. <b>5</b> in. to <b>60</b> ft. depth Wall Thickness: inches or Dia. — in. to — ft. depth gage No. <b>280</b>	
10. Screen: Manufacturer's name <b>Spot By Driller</b> Type <b>PC</b> Dia. <b>5</b> Slot/gauze <b>1/16</b> Length <b>30</b> Set between <b>30</b> ft. and <b>60</b> ft. — ft. and — ft. Gravel pack? <b>yes</b> Size range of material <b>1/16 - 1/2</b>	
11. Static water level: — mo./day/yr. <b>12</b> ft. below land surface Date <b>6-19-76</b>	
12. Pumping level below land surfaces: — ft. after — hrs. pumping — g.p.m. — ft. after — hrs. pumping — g.p.m. Estimated maximum yield — g.p.m.	
13. Water sample submitted: — mo./day/yr. Yes <input checked="" type="checkbox"/> No Date	
14. Well head completion: — Pitless adapter <b>12</b> Inches above grade	
15. Well grouted? <b>yes</b> With: — Neat cement — Bentonite <input checked="" type="checkbox"/> Concrete Depth: From <b>0</b> ft. to <b>10</b> ft.	
16. Nearest source of possible contamination: ft. <b>50</b> Direction <b>W</b> Type <b>creek</b> Well disinfected upon completion? <input checked="" type="checkbox"/> Yes — No	
17. Pump: <input checked="" type="checkbox"/> Not installed Manufacturer's name — HP — Volts — Length of drop pipe — ft. capacity — g.p.m. Type: — Submersible — Turbine — Jet — Reciprocating — Centrifugal — Other	
20. Water well contractor's certification: This well was drilled under my jurisdiction and this report is true to the best of my knowledge and belief. <b>Harper Drill Serv. 176</b> Business name <b>Blue Rapids, ks.</b> License No. — Address <b>6-19-76</b> Signed <b>E. Harper</b> Date <b>6-19-76</b> Authorized representative	

17  
 7  
 12  
 NW  
 SE

Forward the white, blue and pink copies to the Department of Health and Environment

Form WWC-5