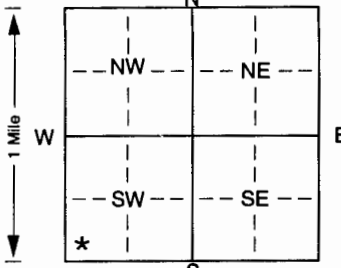


1 LOCATION OF WATER WELL: Fraction NE SW NW NW Section Number 36 1 Township Number T 34 S Range Number R 9 (EW)
 County: Marshall SW $\frac{1}{4}$ SW $\frac{1}{4}$ SW $\frac{1}{4}$

Distance and direction from nearest town or city street address of well if located within city? 39° 44.279 N
1 North, 2 1/2 East & 1 North of Frankfort GPS 096° 22.089 W

2 WATER WELL OWNER: Dan Roeder
 RR#, St. Address, Box # : 8202 W 144 Terrace Board of Agriculture, Division of Water Resources
 City, State, ZIP Code : Overland Park, KS 66223 Application Number:

3 LOCATE WELL'S LOCATION WITH AN "X" IN SECTION BOX:

 4 DEPTH OF COMPLETED WELL: 140 ft. ELEVATION:
 Depth(s) Groundwater Encountered 1. 1 ft. 2. 1 ft. 3. 1 ft.
 WELL'S STATIC WATER LEVEL: 40 ft. below land surface measured on mo/day/yr 9/16/02
 Bore Hole Diameter: 12 in. to 140 ft., and 140 in. to 140 ft.
 WELL WATER TO BE USED AS:
 1 Domestic 3 Feedlot 6 Oil field water supply 9 Dewatering 12 Other (Specify below)
 2 Irrigation 4 Industrial 7 Domestic (lawn & garden) 10 Monitoring well
 Was a chemical/bacteriological sample submitted to Department? Yes. * No. *; If yes, mo/day/yrs sample was submitted
 Water Well Disinfected? Yes * No

5 TYPE OF BLANK CASING USED:
 1 Steel 3 RMP (SR) 5 Wrought iron 8 Concrete tile CASING JOINTS: Glued. * Clamped. *
 2 PVC 4 ABS 6 Asbestos-Cement 9 Other (specify below) Welded *
 7 Fiberglass Threaded *
 Blank casing diameter 5 in. to 120 ft., Dia 18 in. to 200 lbs./ft. Wall thickness or gauge No. 265
 Casing height above land surface: 18 in., weight 200 lbs./ft. Wall thickness or gauge No. 265
 TYPE OF SCREEN OR PERFORATION MATERIAL:
 1 Steel 3 Stainless steel 5 Fiberglass 7 PVC 10 Asbestos-cement
 2 Brass 4 Galvanized steel 6 Concrete tile 8 RMP (SR) 11 Other (specify) *
 9 ABS 12 None used (open hole)
 SCREEN OR PERFORATION OPENINGS ARE:
 1 Continuous slot 3 Mill slot 5 Gauzed wrapped 8 Saw cut 11 None (open hole)
 2 Louvered shutter 4 Key punched 6 Wire wrapped 9 Drilled holes
 7 Torch cut 10 Other (specify) *
 SCREEN-PERFORATED INTERVALS: From 120 ft. to 140 ft., From 120 ft. to 140 ft., From 120 ft. to 140 ft.
 GRAVEL PACK INTERVALS: From 30 ft. to 140 ft., From 30 ft. to 140 ft., From 30 ft. to 140 ft.

6 GROUT MATERIAL: 1 Neat cement 2 Cement grout 3 Bentonite 4 Other *
 Grout Intervals: From 5 ft. to 30 ft., From 5 ft. to 30 ft., From 5 ft. to 30 ft., From 5 ft. to 30 ft.
 What is the nearest source of possible contamination:
 1 Septic tank 4 Lateral lines 7 Pit privy 10 Livestock pens 14 Abandoned water well
 2 Sewer lines 5 Cess pool 8 Sewage lagoon 11 Fuel storage 15 Oil well/Gas well
 3 Watertight sewer lines 6 Seepage pit 9 Feedyard 12 Fertilizer storage 16 Other (specify below)
 13 Insecticide storage
 Direction from well? None Present How many feet?

FROM	TO	LITHOLOGIC LOG	FROM	TO	PLUGGING INTERVALS
0	2	Topsoil			
2	19	Brown Clay			
19	31	Tan Clay			
31	43	Blue Clay			
43	45	Sand (Fine/Blue)			
45	51	Blue Clay			
51	53	Sand (Fine/Blue)			
53	59	Blue Clay			
59	132	Sand (Fine/Yellow)			
132	141	Blue Clay			
141	144	Sand (Fine/Yellow)			
144	155	Blue Clay			
155		Limestone			

7 CONTRACTOR'S OR LANDOWNER'S CERTIFICATION: This water well was (1) constructed, (2) reconstructed, or (3) plugged under my jurisdiction and was completed on (mo/day/year) 9/16/02 and this record is true to the best of my knowledge and belief. Kansas Water Well Contractor's Licence No. 518 This Water Well Record was completed on (mo/day/yr) 9/22/02 under the business name of Blue Valley Drilling by (signature) [Signature]