


1 LOCATION OF WATER WELL: Fraction Section Number Township Number Range Number
 County: Marshall NE 1/2 SE 1/4 9 4 9 (E)W

Distance and direction from nearest town or city street address of well if located within city?
 1/4 mi. E, 3/8 mi. N of Hwy 99 & 10th St., Frankfort

2 WATER WELL OWNER: Jerry Stowell
 RR #, St. Address, Box #: Box 185 Board of Agriculture, Division of Water Resources
 City, State, ZIP Code : Frankfort, KS 66427 Application Number:

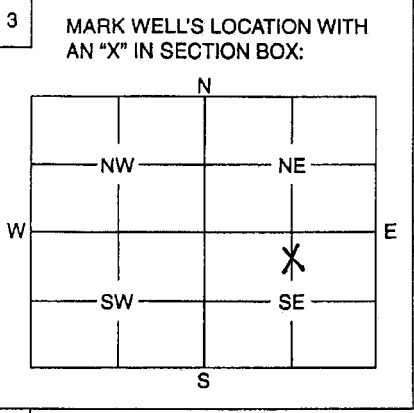

4 DEPTH OF WELL 106 ft.
 WELL'S STATIC WATER LEVEL ft.
 WELL WAS USED AS:
 1 Domestic 5 Public Water Supply 9 Dewatering
 ● Irrigation 6 Oil Field Water Supply 10 Monitoring Well
 3 Feedlot 7 Domestic (Lawn & Garden) 11 Injection Well
 4 Industrial 8 Air Conditioning 12 Other

Was a chemical / bacteriological sample submitted to Department? Yes No ✓
 If yes, mo/day/yr sample was submitted

Water Well Disinfected: Yes No ✓

5 TYPE OF BLANK CASING USED:
 1 Steel 3 RMP (SR) 5 Wrought 7 Fiberglass 9 Other (Specify below)
 ● PVC 4 ABS 6 Asbestos-Cement 8 Concrete Tile

Blank casing diameter 4.5 in. Was casing pulled? Yes ✓ No If yes, how much 106'
 Casing height above or below land surface in.

6 GROUT PLUG MATERIAL: ● Neat cement 2 Cement grout ● Bentonite ● Other .. Clay ..
 Grout Plug Intervals: From 0 ft. to 2 ft., From 2 ft. to 30 ft., From 30 to 106 ft.

What is the nearest source of possible contamination:
 1 Septic tank 6 Seepage pit 11 Fuel storage 16 Other (specify below)
 2 Sewer lines 7 Pit privy 12 Fertilizer storage
 3 Watertight sewer lines 8 Sewage lagoon 13 Insecticide storage
 4 Lateral lines 9 Feedyard 14 Abandoned water well
 5 Cess pool 10 Livestock pens 15 Oil well/Gas well

Direction from well? W How many feet? 500

FROM	TO	PLUGGING MATERIALS
0	2	Clay
2	30	Bentonite
30	106	Neat Cement

North Well
 Pulled casing. Reamed hole to 106' with 8" bit to 106'.

7 CONTRACTOR'S OF LANDOWNER'S CERTIFICATION: This water well was plugged under my jurisdiction and was completed on (mo/day/year) 12/29/2006 and this record is true to the best of my knowledge and belief. Kansas Water Well Contractor's License No. 527 This Water Well Record was completed on (mo/day/year) 1/8/2007 under the business name of GEORGE INC.
 by (signature) *George Inc.*

INSTRUCTIONS: Use typewriter or ball point pen. Please press firmly and print clearly. Please fill in blanks, underline or circle the correct answers. Send top three copies to Kansas Department of Health and Environment, Bureau of Water, Geology Section, 1000 SW Jackson St., Ste. 420, Topeka, Kansas 66612-1367. Telephone: 785/296-5522. Send one to Water Well Owner and retain one for your records.