


1 LOCATION OF WATER WELL: County: Marshall	Fraction SW 1/4 NW 1/4 SE 1/4	Section Number 9	Township Number T 4 S	Range Number R 9 (E/W)
--	---	----------------------------	---------------------------------	---

Distance and direction from nearest town or city street address of well if located within city?
~1/4 mi. N of Tumbleweed Rd. on K9 Hwy, Frankfort

2 WATER WELL OWNER: **KDHE**
 RR#, St. Address, Box # : **1000 SW Jackson St., Suite 410**
 City, State, ZIP Code : **Topeka, KS 66612-1367**
 Board of Agriculture, Division of Water Resources
 Application Number:

3 LOCATE WELL'S LOCATION WITH AN "X" IN SECTION BOX:

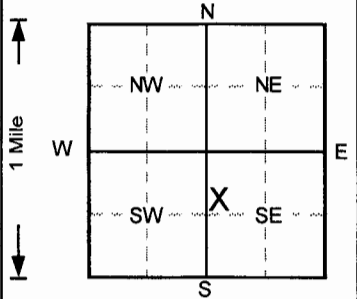

4 DEPTH OF COMPLETED WELL **75** ft. ELEVATION:

Depth(s) Groundwater Encountered 1..... ft. 2..... ft. 3..... ft.

WELL'S STATIC WATER LEVEL ft. below land surface measured on mo/day/yr

Pump test data: Well water was **NA** ft. after hours pumping gpm

Est. Yield **NA** gpm: Well water was ft. after hours pumping gpm

Bore Hole Diameter **8** in. to **77** ft., and in. to ft.

WELL WATER TO BE USED AS: 5 Public water supply 8 Air conditioning 11 Injection well
 1 Domestic 3 Feedlot 6 Oil field water supply 9 Dewatering 12 Other (Specify below)
 2 Irrigation 4 Industrial 7 Lawn and garden only **10** Monitoring well

Was a chemical/bacteriological sample submitted to Department? Yes.....No **✓**; If yes, mo/day/yr sample was submitted

Water Well Disinfected? Yes No **✓**

5 TYPE OF CASING USED: 5 Wrought iron 8 Concrete tile CASING JOINTS: Glued Clamped
 1 Steel 3 RMP (SR) 6 Asbestos-Cement 9 Other (specify below) Welded
2 PVC 4 ABS 7 Fiberglass Threaded. **✓**

Blank casing diameter **2** in. to **60** ft., Dia in. to ft., Dia in. to ft.

Casing height above land surface **32** in., weight lbs./ft. Wall thickness or gauge No. **Sch. 40**

TYPE OF SCREEN OR PERFORATION MATERIAL **7** PVC 10 Asbestos-cement
 1 Steel 3 Stainless steel 5 Fiberglass **8** RMP (SR) 11 Other (specify)
 2 Brass 4 Galvanized steel 6 Concrete tile 9 ABS 12 None used (open hole)

SCREEN OR PERFORATION OPENINGS ARE: 5 Gauzed wrapped 8 Saw cut 11 None (open hole)
 1 Continuous slot **3** Mill slot 6 Wire wrapped 9 Drilled holes
 2 Louvered shutter 4 Key punched 7 Torch cut 10 Other (specify)

SCREEN-PERFORATED INTERVALS: From **60** ft. to **75** ft., From ft. to ft.
 From ft. to ft., From ft. to ft.

GRAVEL PACK INTERVALS: From **57** ft. to **77** ft., From ft. to ft.
 From ft. to ft., From ft. to ft.

6 GROUT MATERIAL: 1 Neat cement 2 Cement grout **3** Bentonite **4** Other **Concrete**

Grout Intervals: From **0** ft. to **3** ft., From **3** ft. to **57** ft., From ft. to ft.

What is the nearest source of possible contamination:
 1 Septic tank 4 Lateral lines 7 Pit privy 10 Livestock pens 14 Abandoned water well
 2 Sewer lines 5 Cess pool 8 Sewage lagoon 11 Fuel storage 15 Oil well/Gas well
 3 Watertight sewer lines 6 Seepage pit 9 Feedyard 12 Fertilizer storage 16 Other (specify below)
 13 Insecticide storage

Direction from well? How many feet?

FROM	TO	LITHOLOGIC LOG	FROM	TO	PLUGGING INTERVALS
0	6	Silt and Clay, Dark Brown	76	77	Sand (f), w/silt, Very Dark Grayish Brown
6	10	Clay and Silt, Dark Yellowish Brown			
10	18	Silt, trace clay, Yellowish Brown			
18	32	Silt, Lt. Brownish Yellow			
32	35	Silt, trace sand, Pale Brown			
35	40	Silt and Clay, trace sand, Lt. Yellowish Brown			
40	45	Sand (f), Lt. Yellowish Brown			
45	50	Sand (f), Brown			
50	55	Sand (m), Pale Brown			
55	57	Sand (m-c), Brownish Yellow			
57	60	Sand (f), Lt. Brownish Gray			
60	61	Sand (f-m), Lt. Brownish Gray			
61	70	Sand (m-c), Grayish Brown			MW6, Abovegrade
70	75	Sand (m-c), some gravel, Brown			Project Name: BM - Frankfort SWP
75	76	Sand (m-c), some gravel, Grayish Brown			GeoCore # 1408, #

7 CONTRACTOR'S OR LANDOWNER'S CERTIFICATION: This water well was **(1)** constructed, (2) reconstructed, or (3) plugged under my jurisdiction and was completed on (mo/day/year) **9/27/2007** and this record is true to the best of my knowledge and belief.
 Kansas Water Well Contractor's License No. **527** This Water Well Record was completed on (mo/day/yr) **10/22/07**
 under the business name of **GeoCore, Inc.** by (signature) *Dale Webb*

OFFICE USE ONLY
T
R
EM
SEC.
1/4
1/4
1/4