


1 LOCATION OF WATER WELL: County: Marshall	Fraction SW ¼ NW ¼ SE ¼	Section Number 9	Township Number T 4 S	Range Number R 9 (E/W)
--	-----------------------------------	----------------------------	---------------------------------	---

Distance and direction from nearest town or city street address of well if located within city?

~1/4 mi. N of Tumbleweed Rd. on K9 Hwy, Frankfort

2 WATER WELL OWNER: KDHE RR#, St. Address, Box # : 1000 SW Jackson St., Suite 410 City, State, ZIP Code : Topeka, KS 66612-1367	Board of Agriculture, Division of Water Resources Application Number:
--	--

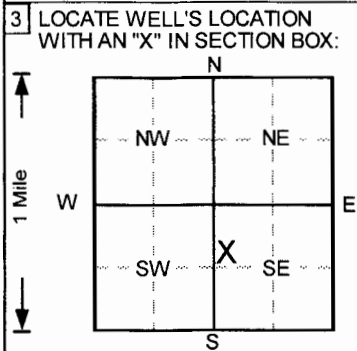

4 DEPTH OF COMPLETED WELL: 75 ft. ELEVATION:
Depth(s) Groundwater Encountered 1. ft. 2. ft. 3. ft.
WELL'S STATIC WATER LEVEL: ft. below land surface measured on mo/day/yr
Pump test data: Well water was NA ft. after hours pumping gpm
Est. Yield NA gpm: Well water was ft. after hours pumping gpm
Bore Hole Diameter 12 in. to 77 ft., and in. to ft.
WELL WATER TO BE USED AS:
5 Public water supply 8 Air conditioning 11 Injection well
1 Domestic 3 Feedlot 6 Oil field water supply 9 Dewatering 12 Other (Specify below)
2 Irrigation 4 Industrial 7 Lawn and garden only 10 Monitoring well
Was a chemical/bacteriological sample submitted to Department? Yes.....No <input checked="" type="checkbox"/> ; If yes, mo/day/yr sample was submitted
Water Well Disinfected? Yes No <input checked="" type="checkbox"/>

5 TYPE OF BLANK CASING USED:	5 Wrought iron	8 Concrete tile	CASING JOINTS: Glued Clamped
1 Steel	3 RMP (SR)	6 Asbestos-Cement	9 Other (specify below)
2 PVC	4 ABS	7 Fiberglass	Welded
Blank casing diameter 6 in. to 75 ft., Dia 6 in. to 55 ft., Dia in. to ft.			Threaded. <input checked="" type="checkbox"/>
Casing height above land surface 36 in., weight lbs./ft. Wall thickness or gauge No. Sch. 40			
TYPE OF SCREEN OR PERFORATION MATERIAL	7 PVC	10 Asbestos-cement	
1 Steel	3 Stainless steel	5 Fiberglass	8 RMP (SR)
2 Brass	4 Galvanized steel	6 Concrete tile	9 ABS
SCREEN OR PERFORATION OPENINGS ARE:	5 Gauzed wrapped	8 Saw cut	11 None (open hole)
1 Continuous slot	3 Mill slot	6 Wire wrapped	9 Drilled holes
2 Louvered shutter	4 Key punched	7 Torch cut	10 Other (specify)
SCREEN-PERFORATED INTERVALS: From 55 ft. to 70 ft., From ft. to ft.			
GRAVEL PACK INTERVALS: From 52 ft. to 77 ft., From ft. to ft.			

6 GROUT MATERIAL: 1 Neat cement 2 Cement grout 3 Bentonite 4 Other Concrete
Grout Intervals: From 0 ft. to 3 ft., From 3 ft. to 52 ft., From ft. to ft.
What is the nearest source of possible contamination:
1 Septic tank 4 Lateral lines 7 Pit privy 10 Livestock pens 14 Abandoned water well
2 Sewer lines 5 Cess pool 8 Sewage lagoon 11 Fuel storage 15 Oil well/Gas well
3 Watertight sewer lines 6 Seepage pit 9 Feedyard 12 Fertilizer storage 16 Other (specify below)
13 Insecticide storage
Direction from well? How many feet?

FROM	TO	LITHOLOGIC LOG	FROM	TO	PLUGGING INTERVALS
0	3	Clay and Silt, Dark Brown	72	75	Silt and fine gravel, Lt. Yellowish Brown
3	10	Silt w/clay, Dark Yellowish Brown	75	77	Sand (f), Lt. Yellowish Brown
10	15	Clay, some silt, Dark Yellowish Brown			
15	20	Silt and Clay, Yellowish Brown			
20	29	Silt, Lt. Yellowish Brown			1" PVC piezometer installed in same borehole adjacent to 6" well to 75' with 5' screen on bottom.
29	35	Silt, trace clay, trace sand, Pale Brown			
35	40	Silt, trace sand, trace clay, Lt. Grayish Brown			
40	45	Silt and Sand, Grayish Brown			
45	49	Sand (f-c), Grayish Brown			
49	50	Silt w/sand, Grayish Brown			
50	55	Sand (m-c), Pale Brown			
55	60	Sand (m-c), Brown			
60	65	Sand (c), Yellowish Brown			RW1, Abovegrade
65	70	Sand (c) and Gravel, Brown			Project Name: BM - Frankfort SWP
70	72	Sand (f), Lt. Yellowish Brown			GeoCore # 1408, #

CORRECTED

7 CONTRACTOR'S OR LANDOWNER'S CERTIFICATION: This water well was (1) constructed, (2) reconstructed, or (3) plugged under my jurisdiction and was completed on (mo/day/year) 9/28/2007 and this record is true to the best of my knowledge and belief.
Kansas Water Well Contractor's License No. 527 This Water Well Record was completed on (mo/day/yr) 10/30/2007 under the business name of GeoCore, Inc. by (signature) <i>Dale Hill</i>