

1 LOCATION OF WATER WELL:	Fraction	Section Number	Township Number	Range Number
County: Washington	NE ¼ SE ¼ NW ¼	15	T 5 S	R 1 E

Distance and direction from nearest town or city street address of well if located within city?

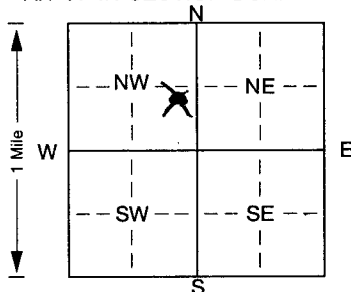
1 1/2 mile West & 3 1/2 mile North of Clifton, KS2 WATER WELL OWNER: **Kent Condray**RR#, St. Address, Box # : **471 Bismark Rd.**City, State, ZIP Code : **Clifton, KS 66937**

Board of Agriculture, Division of Water Resources

Application Number: **44171**

3 LOCATE WELL'S LOCATION WITH

AN "X" IN SECTION BOX:

4 DEPTH OF COMPLETED WELL: **190** ft. ELEVATION:

Depth(s) Groundwater Encountered 1. ft. 2. ft. 3. ft.

WELL'S STATIC WATER LEVEL: **59** ft. below land surface measured on mo/day/yr

Pump test data: Well water was ft. after hours pumping gpm

Est. Yield gpm: Well water was ft. after hours pumping gpm

Bore Hole Diameter: **28** in. to **190** ft., and in. to ft.

WELL WATER TO BE USED AS: 5 Public water supply 8 Air conditioning 11 Injection well

1 Domestic 3 Feedlot 6 Oil field water supply 9 Dewatering 12 Other (Specify below)

☒ Irrigation 4 Industrial 7 Domestic (lawn & garden) 10 Monitoring wellWas a chemical/bacteriological sample submitted to Department? Yes. No ☒ ; If yes, mo/day/yr sample was submittedWater Well Disinfected? Yes ☒ No

5 TYPE OF BLANK CASING USED:

1 Steel

3 RMP (SR)

5 Wrought iron

8 Concrete tile

CASING JOINTS: Glued ☒ Clamped☒ PVC

4 ABS

6 Asbestos-Cement

9 Other (specify below)

Welded

Blank casing diameter: **16** in. to **110** ft., Dia in. to ft., Dia in. to ft.Casing height above land surface: **12** in., weight **16.15** lbs./ft. Wall thickness or gauge No. **500**

7 Fiberglass

Threaded

TYPE OF SCREEN OR PERFORATION MATERIAL:

1 Steel

3 Stainless steel

5 Fiberglass

☒ PVC

10 Asbestos-cement

2 Brass

4 Galvanized steel

6 Concrete tile

8 RMP (SR)

11 Other (specify)

9 ABS

12 None used (open hole)

SCREEN OR PERFORATION OPENINGS ARE:

1 Continuous slot

☒ Mill slot

5 Gauzed wrapped

8 Saw cut

11 None (open hole)

2 Louvered shutter

4 Key punched

6 Wire wrapped

9 Drilled holes

7 Torch cut

10 Other (specify) ft.

SCREEN-PERFORATED INTERVALS: From: **110** ft. to **190** ft., From ft. to ft.

From: ft. to ft., From ft. to ft.

GRAVEL PACK INTERVALS: From: **25** ft. to **190** ft., From ft. to ft.

From: ft. to ft., From ft. to ft.

6 GROUT MATERIAL:

1 Neat cement

☒ Cement grout

3 Bentonite

4 Other

Grout Intervals: From: **2** ft. to **25** ft., From ft. to ft., From ft. to ft.What is the nearest source of possible contamination: **None within 1/2 mile**

1 Septic tank

4 Lateral lines

7 Pit privy

0 Livestock pens

14 Abandoned water well

2 Sewer lines

5 Cess pool

8 Sewage lagoon

11 Fuel storage

15 Oil well/Gas well

3 Watertight sewer lines

6 Seepage pit

9 Feedyard

12 Fertilizer storage

16 Other (specify below)

13 Insecticide storage

Direction from well?

How many feet?

FROM	TO	LITHOLOGIC LOG	FROM	TO	PLUGGING INTERVALS
0	3	Topsoil			
3	15	Clay, dark brown			
15	28	Clay, brown			
28	70	Shale, gray			
70	75	Sandrock & Shale			
75	90	Sandstone, dark			
90	115	Sandstone, tan			
115	126	Shale, gray			
126	189	Sandstone, tan			
189	190	Shale, gray			

7 CONTRACTOR'S OR LANDOWNER'S CERTIFICATION: This water well was ☒ (1) constructed, (2) reconstructed, or (3) plugged under my jurisdiction and wascompleted on (mo/day/year) **12/3/01** and this record is true to the best of my knowledge and belief. KansasWater Well Contractor's Licence No. **138** This Water Well Record was completed on (mo/day/yr) **12/5/01**under the business name of **Peterson Irrigation, Inc.**by (signature) *Mike Peterson*