

1 LOCATION OF WATER WELL:	Fraction	Section Number	Township Number	Range Number
County: Washington	NE ¼ SE ¼ NW ¼	11	T 5 S	R 1 E X


Distance and direction from nearest town or city street address of well if located within city?

5 miles North & 1/2 mile West of Clifton, KS2 WATER WELL OWNER: **John Leiszler**RR#, St. Address, Box # : **417 Deer Rd.**

Board of Agriculture, Division of Water Resources

City, State, ZIP Code : **Clifton, KS 66937**Application Number: **44,509**3 LOCATE WELL'S LOCATION WITH 4 DEPTH OF COMPLETED WELL. **155** ft. ELEVATION:

AN "X" IN SECTION BOX:

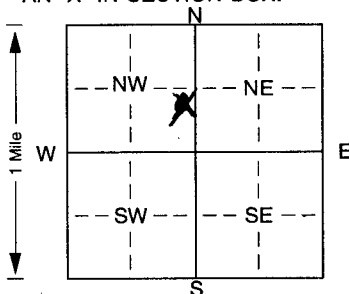

Depth(s) Groundwater Encountered 1. ft. 2. ft. 3. ft.

WELL'S STATIC WATER LEVEL **57** ft. below land surface measured on mo/day/yr **12/11/01**Pump test data: Well water was **132** ft. after **8** hours pumping **450-500** gpmEst. Yield **450** gpm: Well water was ft. after hours pumping gpmBore Hole Diameter. **28** in. to **155** ft., and. in. to ft.

WELL WATER TO BE USED AS: 5 Public water supply 8 Air conditioning 11 Injection well

1 Domestic 3 Feedlot 6 Oil field water supply 9 Dewatering 12 Other (Specify below)

2 Irrigation 4 Industrial 7 Domestic (lawn & garden) 10 Monitoring wellWas a chemical/bacteriological sample submitted to Department? Yes. No. **X** ; If yes, mo/day/yr sample was submittedWater Well Disinfected? Yes **X** No5 TYPE OF BLANK CASING USED: 5 Wrought iron 8 Concrete tile CASING JOINTS: Glued. **X** Clamped.

1 Steel 3 RMP (SR) 6 Asbestos-Cement 9 Other (specify below) Welded

X PVC 4 ABS 7 Fiberglass Threaded.Blank casing diameter **16** in. to **95** ft., Dia in. to ft., Dia in. to ft.Casing height above land surface. **12** in., weight **16.15** lbs./ft. Wall thickness or gauge No. **.500**

TYPE OF SCREEN OR PERFORATION MATERIAL:

1 Steel 3 Stainless steel 5 Fiberglass **X** PVC 10 Asbestos-cement

2 Brass 4 Galvanized steel 6 Concrete tile 8 RMP (SR) 11 Other (specify)

SCREEN OR PERFORATION OPENINGS ARE: 5 Gauzed wrapped 8 Saw cut 11 None (open hole)

1 Continuous slot **3** Mill slot 6 Wire wrapped 9 Drilled holes

2 Louvered shutter 4 Key punched 7 Torch cut 10 Other (specify) ft.

SCREEN-PERFORATED INTERVALS: From. **95** ft. to **155** ft., From ft. to ft.

From. ft. to ft., From ft. to ft.

GRAVEL PACK INTERVALS: From. **24** ft. to **155** ft., From ft. to ft.

From. ft. to ft., From ft. to ft.

6 GROUT MATERIAL: 1 Neat cement **X** Cement grout 3 Bentonite 4 OtherGrout Intervals: From. **3** ft. to **24** ft., From ft. to ft., From ft. to ft.What is the nearest source of possible contamination: **None within 1/4 mile** 10 Livestock pens 14 Abandoned water well

1 Septic tank 4 Lateral lines 7 Pit privy 11 Fuel storage 15 Oil well/Gas well

2 Sewer lines 5 Cess pool 8 Sewage lagoon 12 Fertilizer storage 16 Other (specify below)

3 Watertight sewer lines 6 Seepage pit 9 Feedyard 13 Insecticide storage

Direction from well? How many feet?

FROM	TO	LITHOLOGIC LOG	FROM	TO	PLUGGING INTERVALS
0	4	Topsoil			
4	15	Clay, gray			
15	28	Clay, brown			
28	30	Sandrock			
30	42	Shale, red and gray			
42	60	Sandstone, soft			
60	84	Shale, gray			
84	125	Sandstone, soft, red, coarse			
125	155	Sandstone, red, soft with shale			

7 CONTRACTOR'S OR LANDOWNER'S CERTIFICATION: This water well was **X** constructed, (2) reconstructed, or (3) plugged under my jurisdiction and was completed on (mo/day/year) **12/12/01** and this record is true to the best of my knowledge and belief. Kansas Water Well Contractor's Licence No. **138** This Water Well Record was completed on (mo/day/yr) **12/18/01** under the business name of **Peterson Irrigation, Inc.** by (signature) *Mike Peters*