

1	LOCATION OF WATER WELL:	Fraction	Section Number	Township Number	Range Number
County:	Washington	NE $\frac{1}{4}$ SW $\frac{1}{4}$ SE $\frac{1}{4}$	17	T 5 S	R 1 E N

Distance and direction from nearest town or city street address of well if located within city?

4 miles East & 2 miles North of Clyde, KS


2 WATER WELL OWNER: **Kent Condray, Condray Farms**

RR#, St. Address, Box # : **471 Bismark Rd.**
City, State, ZIP Code : **Clifton, KS 66937**

Board of Agriculture, Division of Water Resources
Application Number: **27,674**

3 LOCATE WELL'S LOCATION WITH AN "X" IN SECTION BOX:

4 DEPTH OF COMPLETED WELL157..... ft. ELEVATION:

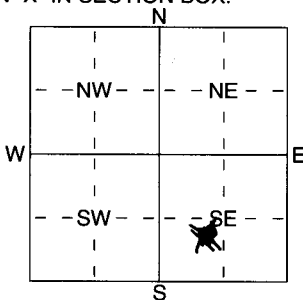

Depth(s) Groundwater Encountered 1 ft. 2 ft. 3 ft.
WELL'S STATIC WATER LEVEL 60 ft. below land surface measured on mo/day/yr 3/12/03

Pump test data: Well water was ft. after hours pumping gpm
 Est. Yield **500.** gpm: Well water was ft. after hours pumping gpm

WELL WATER TO BE USED AS:

1 Domestic	3 Feedlot	5 Public water supply	8 Air conditioning	11 Injection well
☒ Irrigation	4 Industrial	6 Oil field water supply	9 Dewatering	12 Other (Specify below)
		7 Domestic (lawn & garden)	10 Monitoring well	

Was a chemical/bacteriological sample submitted to Department? Yes No ...**X**....; If yes, mo/day/yr sample was submitted
Water Well Disinfected? Yes **X** No

5	TYPE OF BLANK CASING USED:
---	----------------------------

1 Steel	3 RMP (SR)
X PVC	4 ABS

5 Wrought iron
6 Asbestos-Cement
7 Fiberglass

8 Concrete tile
9 Other (specify below)

CASING JOINTS: Glued ☒ Clamped
Welded
Threaded

Blank casing diameter 16 in. to 97 ft. Dia _____ in. to _____ ft. Dia _____ in. to _____ ft.

Casing height above land surface **12** in., weight **16.15** lbs./ft. Wall thickness or gauge No. **.500**

TYPE OF SCREEN OR PERFORATION MATERIAL:

1 Steel
2 Brass
3 Stainless Steel
4 Galvanized Steel

5 Fiberglass
6 Concrete tile

X PVC

8 RMP (SR)
9 ABS

10 Asbestos-Cement
11 Other (Specify)
12 None used (open hole)

SCREEN OR PERFORATION OPENINGS ARE:

1 Continuous slot ☒ Mill slot
2 Louvered shutter 4 Key punched

5 Guazed wrapped
6 Wire wrapped
7 Torch cut

8 Saw cut
9 Drilled holes
10 Other (specify)
11 None (open hole)

SCREEN-PERFORATED INTERVALS: From 97 ft. to 157 ft., From _____ ft. to _____ ft.

GRAVEL PACK INTERVALS: From 20 ft. to 157 ft. From _____ ft. to _____ ft.
From _____ ft. to _____ ft. From _____ ft. to _____ ft.

6	GROUT MATERIAL:	1 Neat cement	☒ Cement grout	3 Bentonite	4 Other
---	-----------------	---------------	--	-------------	---------------

Grout Intervals: From 0 ft. to 20 ft., From _____ ft. to _____ ft., From _____ ft. to _____ ft.

What is the nearest source of possible contamination: **None within 1/4 mile**

1 Septic tank	4 Lateral lines	7 Pit privy	10 Livestock pens	14 Abandoned water well
2 Sewer lines	5 Cess pool	8 Sewage lagoon	11 Fuel storage	15 Oil well/Gas well
			12 Fertilizer storage	16 Other (specify below)

3 Watertight sewer lines 6 Seepage pit

How many feet?

[illegible]

7. CONTRACTOR'S OR LANDOWNER'S CERTIFICATION: This water well was ☒ constructed, (2) reconstructed, or (3) plugged under my jurisdiction and was completed on (mo/day/year) 3/20/03 and this record is true to the best of my knowledge and belief. Kansas

Water Well Contractor's Licence No. **138** This Water Well Record was completed on (mo/day/yr) **3/21/03**
under the business name of **Peterson Irrigation, Inc.** by (signature) *M. L. Peterson*