

WATER WELL PLUGGING RECORD Form WWC-5P KSA 82a-1212 ID NO.

[]

1 LOCATION OF WATER WELL: Fraction NW 1/4 NW 1/4 SE 1/4 NW 1/4 Section Number 2 Township Number T 5 S Range Number 1 E W
 County: Washington

Street/Rural Address of Well Location; if unknown, distance & direction from nearest town or intersection: If at owner's address, check here

1,940 feet southeast of Deer Rd and 6th Rd

Global Positioning Systems (GPS) information:

Latitude: 39.6501940 (in decimal degrees)

Longitude: -97.2886110 (in decimal degrees)

Elevation: _____

Datum: WGS84, NAD83, NAD27

Collection Method: _____


GPS unit (Make/Model: NAD83)

Digital Map/Photo, Topographic Map, Land Survey

Est. Accuracy: < 3 m, 3-5 m, 5-15 m, > 15 m

2 WATER WELL OWNER: Dean Herra
 RR#, St. Address, Box #: 1178 8th Rd
 City, State ZIP Code: Linn, KS 66935

3 MARK WELL'S LOCATION WITH AN "X" IN SECTION BOX:

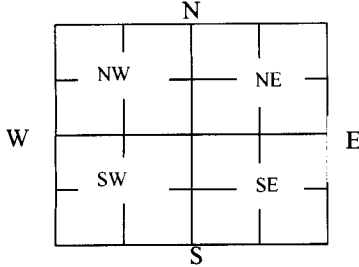

4 DEPTH OF WELL 183 ft.

WELL'S STATIC WATER LEVEL 84 ft

WELL WAS USED AS:

- Domestic
- Irrigation
- Feedlot
- Industrial

- Public Water Supply
- Oil Field Water Supply
- Domestic (Lawn & Garden)
- Air Conditioning

- Dewatering
- Monitoring
- Injection Well
- Other _____

Was a chemical/bacteriological sample submitted to Department? Yes No

5 TYPE OF BLANK CASING USED:

- Steel
- RMP (SR)
- Wrought
- Fiberglass
- Other (Specify below)
- PVC
- ABS
- Asbestos-Cement
- Concrete Tile
- Transite

Blank casing diameter 12 in. Was casing pulled? Yes No If yes, how much _____
 Casing height above or below land surface 8 in.

6 GROUT PLUG MATERIAL: Neat cement Cement grout Bentonite Other _____

Grout Plug Intervals: From 0 ft. to 10 ft., From 64 ft. to 74 ft., From _____ to _____ ft.

What is the nearest source of possible contamination:

- Septic tank
- Sewer lines
- Watertight sewer lines
- Lateral lines
- Cess pool
- Seepage pit
- Pit privy
- Sewage lagoon
- Feedyard
- Livestock pens
- Fuel Storage
- Fertilizer storage
- Insecticide storage
- Abandoned water well
- Oil well/Gas well
- Other (specify below) _____

Direction from well? Southeast
 How many feet? 4,200

FROM	TO	PLUGGING MATERIALS	FROM	TO	PLUGGING MATERIALS
0	10	Bentonite Seal			
10	64	Gravel Well Pack			
64	74	Bentonite Seal			
74	183	Gravel Well Pack			

7 CONTRACTOR'S OR LANDOWNER'S CERTIFICATION: This water well was plugged under my jurisdiction and was completed on (mo/day/year) 7/23/2014 and this record is true to the best of my knowledge and belief. Kansas Water Well Contractor's License No. 755. This Water Well Record was completed on (mo/day/year) 09/12/2014 under the business name of Sargent Drilling by (signature) _____

INSTRUCTIONS: Use typewriter or ballpoint pen. Please press firmly and print clearly. Please fill in blanks, underline or circle the correct answers. Send top three copies to Kansas Department of Health and Environment, Bureau of Water, Geology Section, 1000 SW Jackson St., Ste. 420, Topeka, Kansas 66612-1367. Telephone: 785/296-5524. Send one to Water Well Owner and retain one for your records. Visit us at <http://www.kdheks.gov/waterwell/index.html>.

Check one: White Copy Blue Copy Pink Copy