

1 LOCATION OF WATER WELL:	Fraction	Section Number	Township Number	Range Number
County: <u>Washington</u>	<u>Near 1/4 Center 1/4 SE 1/4</u>	<u>8</u>	<u>T 5 S</u>	<u>R 1</u>

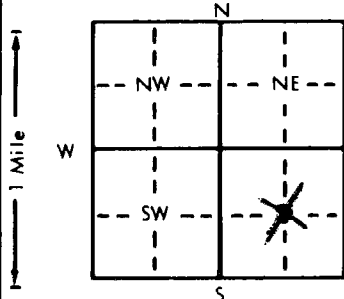
Distance and direction from nearest town or city street address of well if located within city?

3 miles North & 2 3/4 miles East of Clyde2 WATER WELL OWNER: Scott CondrayRR#, St. Address, Box # : R.R.

Board of Agriculture, Division of Water Resources

City, State, ZIP Code : Clifton, KS 66937Application Number: 40,405

3 LOCATE WELL'S LOCATION WITH AN "X" IN SECTION BOX:


WELL WATER TO BE USED AS: 5 Public water supply 8 Air conditioning 11 Injection well

1 Domestic 3 Feedlot 6 Oil field water supply 9 Dewatering 12 Other (Specify below)

2 Irrigation 4 Industrial 7 Lawn and garden only 10 Monitoring well

Was a chemical/bacteriological sample submitted to Department? Yes XXXX No XXXX; If yes, mo/day/yr sample was submittedWater Well Disinfected? Yes XXXX No XXXX

5 TYPE OF BLANK CASING USED:

5 Wrought iron

8 Concrete tile

CASING JOINTS: Glued XXXX Clamped XXXX

1 Steel

3 RMP (SR)

6 Asbestos-Cement

9 Other (specify below)

Welded XXXX

2 PVC

4 ABS

7 Fiberglass

Threaded XXXXBlank casing diameter 16 in. to 96 ft., Dia 16 in. to 96 ft., Dia 16 in. to 96 ft.Casing height above land surface 12 in., weight 16.15 lbs./ft. Wall thickness or gauge No. 500

TYPE OF SCREEN OR PERFORATION MATERIAL:

7 PVC

10 Asbestos-cement

1 Steel

3 Stainless steel

5 Fiberglass

8 RMP (SR)

11 Other (specify) XXXX

2 Brass

4 Galvanized steel

6 Concrete tile

9 ABS

12 None used (open hole)

SCREEN OR PERFORATION OPENINGS ARE:

5 Gauzed wrapped

8 Saw cut

11 None (open hole)

1 Continuous slot

3 Mill slot

6 Wire wrapped

9 Drilled holes

2 Louvered shutter

4 Key punched

7 Torch cut


6 GROUT MATERIAL:

1 Neat cement

2 Cement grout

3 Bentonite

4 Other XXXXGrout Intervals: From 0 ft. to 20 ft., From 0 ft. to 20 ft., From 0 ft. to 20 ft.What is the nearest source of possible contamination: None within 1/2 mile

10 Livestock pens

14 Abandoned water well

1 Septic tank

4 Lateral lines

7 Pit privy

11 Fuel storage

15 Oil well/Gas well

2 Sewer lines

5 Cess pool

8 Sewage lagoon

12 Fertilizer storage

16 Other (specify below)

3 Watertight sewer lines

6 Seepage pit

9 Feedyard

13 Insecticide storage

Direction from well?

How many feet?

FROM	TO	LITHOLOGIC LOG	FROM	TO	PLUGGING INTERVALS
0	3	Top Soil			
3	5	Gray Clay			
5	10	Tan Clay			
10	13	Brown Clay			
13	42	Tan Clay			
42	47	Clay with small Sandrock layers			
47	51	Clay			
51	53	Dark Gray Shale			
53	59	Light Gray Shale			
59	64	Gray Brown & Red Shale layers			
64	104	Gray Shale			
104	108	Gray Shale & Small Sandstone layers			
108	157	Brown Sandstone			

7 CONTRACTOR'S OR LANDOWNER'S CERTIFICATION: This water well was (1) constructed, (2) reconstructed, or (3) plugged under my jurisdiction and was completed on (mo/day/year) 6-11-93 and this record is true to the best of my knowledge and belief. KansasWater Well Contractor's License No. 138 This Water Well Record was completed on (mo/day/yr) 6-23-93under the business name of Peterson Irrigation Inc.by (signature) Mike Peterson