32

USE TYPEWRITER OR BALL POINT PEN-PRESS FIRMLY, PRINT CLEARLY.

WATER WELL RECORD
KSA 82a-1201-1215

Kansas Department of Health and Environment-Division of Environment
(Water well Contractors)
Topeka, Kansas 66620

1. Location of well:	County	Fraction	Section number	Township number	Range number
	WASHINGTON	NW1/4 SW1/4 SW1/4	13	T 5 S	R 1 (E/W)

2. Distance and direction from nearest town or city: 3 NORTH
Street address of well location if in city: CLIFTON

3. Owner of well: MAKIN BEACON INC
R.R. or street: RR #2
City, state, zip code: CLIFTON, KANSAS 66937

4. Locate with "X" in section below:

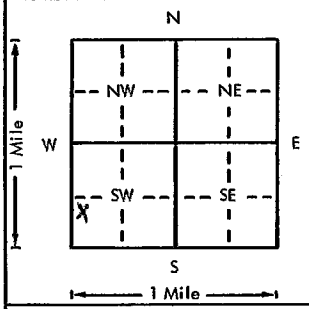

Sketch map:

6. Bore hole dia. 8 in. Completion date
Well depth 116 ft. 3/20/76

7. __ Cable tool X Rotary __ Driven __ Dug
__ Hollow rod __ Jetted __ Bored __ Reverse rotary

8. Use: __ Domestic __ Public supply __ Industry
__ Irrigation __ Air conditioning X Stock
__ Lawn __ Oil field water __ Other

9. Casing: Material PVC Height: Above or below
Threaded ___ Welded X Surface 24 in.
RMP ___ PVC X Weight 3 lbs./ft.
Dia. 5 in. to 116 ft. depth Wall Thickness: inches or
Dia. ___ in. to ___ ft. depth gage No. 1214

5. Type and color of material	From	To
TOPSOIL	0	3
BROWN CLAY	3	11
SANDY CLAY	11	13
RED CLAY	13	28
BLUE CLAY	28	32
SANDROCK 6'	32	38
BROWN YELLOW CLAY	38	46
BLUE CLAY	46	57
BLUE CLAY W/ ROCK LAYERS	57	62
SANDROCK 64'	62	116
STOP	116	

(Use a second sheet if needed)

10. Screen: Manufacturer's name
PUMPCO
Type PVC Dia. 5"
Slot/gauze 1/16 Length 20'
Set between 116 ft. and 96 ft.
ft. and ft.
Gravel pack? YES Size range of material 10 x 14

11. Static water level: mo./day/yr.
55 ft. below land surface Date 3/28/76

12. Pumping level below land surfaces:
ft. after hrs. pumping g.p.m.
ft. after hrs. pumping g.p.m.
Estimated maximum yield 50 g.p.m.

13. Water sample submitted: mo./day/yr.
__ Yes X No Date

14. Well head completion:
X Pitless adapter __ Inches above grade

15. Well grouted? YES
With: X Neat cement __ Bentonite __ Concrete
Depth: From 3 ft. to 13 ft.

16. Nearest source of possible contamination:
ft. 300 Direction EAST Type LAGOON
Well disinfected upon completion? X Yes __ No

17. Pump: X Not installed
Manufacturer's name
Model number HP Volts
Length of drop pipe ft. capacity g.p.m.
Type:
__ Submersible __ Turbine
__ Jet __ Reciprocating
__ Centrifugal __ Other

18. Elevation: 1317'
Topography:
__ Hill
__ Slope
X Upland
__ Valley

19. Remarks:

20. Water well contractor's certification:
This well was drilled under my jurisdiction and this report is true to the best of my knowledge and belief.
GEO COX & SONS INC 258
Business name License No.
Address CLIFTON, KANS 66937
Signed David Cox Date
Authorized representative 3/25/76

T 5 R 1 (E/W) Sec 13 1/4 NW 1/4 SW 1/4 SW 1/4

Forward the white, blue and pink copies to the Department of Health and Environment

Form WWC-5

MI-1023