USE TYPEWRITER OR BALL POINT PEN-PRESS FIRMLY, PRINT CLEARLY.

WATER WELL RECORD
KSA 82a-1201-1215

Kansas Department of Health and Environment-Division of Environment
(Water well Contractors)
Topeka, Kansas 66620

1. Location of well:	County: Washington	Fraction: SE 1/4 NW 1/4 SE 1/4	Section number: 35	Township number: T 5 S	Range number: R 1 (E) W

2. Distance and direction from nearest town or city: in Clifton
Street address of well location if in city: City limits

3. Owner of well: Ralph A. Beswick
R.R. ~~or street~~: #1
City, state, zip code: Clifton Kansas 66937

4. Locate with "X" in section below:

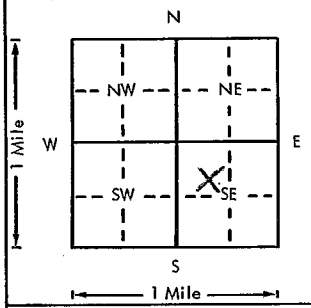

Sketch map:

5. Type and color of material	From	To
Clay	0	53
sand rock	53	80
clay	80	

(Use a second sheet if needed)

6. Bore hole dia. 8 in. Completion date 10-3-77
Well depth 80 ft.

7. __ Cable tool X Rotary __ Driven __ Dug
__ Hollow rod __ Jetted __ Bored __ Reverse rotary

8. Use: X Domestic __ Public supply __ Industry
__ Irrigation __ Air conditioning __ Stock
__ Lawn __ Oil field water __ Other

9. Casing: Material PVC Height: Above ~~or below~~
Threaded ___ Welded X Surface 12 in.
RMP ___ PVC X Weight 3 lbs./ft.
Dia. 5 in. to 80 ft. depth Wall Thickness: inches or
Dia. ___ in. to ___ ft. depth ~~gage No.~~ 258

10. Screen: Manufacturer's name Pompco
Type PVC Dia. 5"
Slot/~~gauze~~ 1/16" Length 10
Set between 70 ft. and 80 ft.
___ ft. and ___ ft.
Gravel pack? YES Size range of material 1/16-1/4"

11. Static water level: mo./day/yr.
52 ft. below land surface Date 10-3-77

12. Pumping level below land surfaces:
70 ft. after 1 hrs. pumping 30 g.p.m.
___ ft. after ___ hrs. pumping ___ g.p.m.
Estimated maximum yield 50 g.p.m.

13. Water sample submitted: mo./day/yr.
__ Yes X No Date ___

14. Well head completion:
__ Pitless adapter 12 Inches above grade

15. Well grouted? YES
With: __ Neat cement __ Bentonite X Concrete
Depth: From 0 ft. to 10 ft.

16. Nearest source of possible contamination: SEWER LINE
ft. 50 Direction N Type
Well disinfected upon completion? X Yes __ No

17. Pump: X Not installed
Manufacturer's name ___
Model number ___ HP ___ Volts ___
Length of drop pipe ___ ft. capacity ___ g.p.m.
Type:
__ Submersible __ Turbine
__ Jet __ Reciprocating
__ Centrifugal __ Other

18. Elevation: 1330'
Topography:
X Hill
__ Slope
__ Upland
__ Valley

19. Remarks:

20. Water well contractor's certification:
This well was drilled under my jurisdiction and this report is true to the best of my knowledge and belief.
Geo Cox + Sons Inc 258
Business name License No.
Address Clifton Kansas 669
Signed Francis Cox Date 10-5
Authorized representative

T 5 R 1 (E) W Sec 35 1/4 SE 1/4 NW 1/4 SE 1/4

Forward the white, blue and pink copies to the Department of Health and Environment

Form WWC-5

MI-1023