USE TYPEWRITER OR BALL POINT PEN-PRESS FIRMLY, PRINT CLEARLY.

WATER WELL RECORD
KSA 82a-1201-1215

Kansas Department of Health and Environment-Division of Environment
(Water well Contractors)
Topeka, Kansas 66620

1. Location of well:	County	Fraction	Section number	Township number	Range number
	WASHINGTON	SE 1/4 SW 1/4 SW 1/4	36	T 5 S	R 1 E W

2. Distance and direction from nearest town or city: EAST EDGE
Street address of well location if in city: CLIFTON

3. Owner of well: DENNIS CHAPUT
R.R. or street:
City, state, zip code: CLIFTON, KANS 66939

4. Locate with "X" in section below: Sketch map:

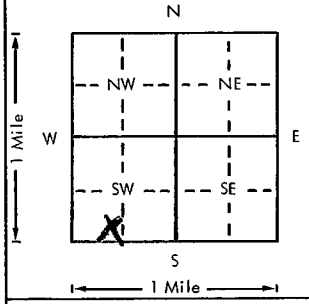

6. Bore hole dia. 8 in. Completion date
Well depth 76 ft. 4-11-79

7. __ Cable tool X Rotary __ Driven __ Dug
__ Hollow rod __ Jetted __ Bored __ Reverse rotary

8. Use: X Domestic __ Public supply __ Industry
__ Irrigation __ Air conditioning __ Stock
__ Lawn __ Oil field water __ Other

9. Casing: Material PVC Height (Above) or below
Threaded __ Welded X Surface 12 in.
RMP __ PVC X Weight 3 lbs./ft.
Dia. 5 in. to 76 ft. depth Wall Thickness: inches or
Dia. __ in. to __ ft. depth Gage No. 1258

5. Type and color of material	From	To
TOPSOIL	0	3
CLAY W/ ROCK LAYERS	3	30
SANDROCK	30	35
RED CLAY	35	60
SANDROCK	60	74
BLUE SHALE	74	76
STOP	76	

(Use a second sheet if needed)

10. Screen: Manufacturer's name PUMPCO
Type PVC Dia. 5"
Slot/gauze 1/16 Length 20'
Set between 56 ft. and 76 ft.
ft. and ft.
Gravel pack? YES Size range of material 1/4"

11. Static water level: mo./day/yr.
50 ft. below land surface Date 4-11-79

12. Pumping level below land surfaces:
ft. after N/A hrs. pumping g.p.m.
ft. after hrs. pumping g.p.m.
Estimated maximum yield 20 g.p.m.

13. Water sample submitted: mo./day/yr.
__ Yes X No Date

14. Well head completion:
__ Pitless adapter 12 Inches above grade

15. Well grouted? YES
With: X Neat cement __ Bentonite __ Concrete
Depth: From 4 ft. to 14 ft.

16. Nearest source of possible contamination: SOLID
ft. 200 Direction SOUTH Type SEWER
Well disinfected upon completion? X Yes __ No

17. Pump: X Not installed
Manufacturer's name
Model number HP Volts
Length of drop pipe ft. capacity g.p.m.
Type:
__ Submersible __ Turbine
__ Jet __ Reciprocating
__ Centrifugal __ Other

18. Elevation: 1280
Topography:
__ Hill
__ Slope
X Upland
__ Valley

19. Remarks:

20. Water well contractor's certification:
This well was drilled under my jurisdiction and this report is true to the best of my knowledge and belief.
Daryl Cox & Sons Inc 359
Business name License No.
Address CLIFTON KANS 66939
Signed Daryl Cox Date
Authorized representative

T 5 R 1 E W Sec 36 1/4 1/4 1/4 SE SW SW

Forward the white, blue and pink copies to the Department of Health and Environment

Form WWC-5

MI-1023