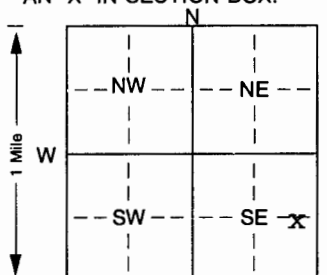


1 LOCATION OF WATER WELL: Fraction NE 1/4 NE 1/4 SE 1/4 Section Number 36 Township Number T 5 S Range Number R 14 E 5W
 County: nemaha

Distance and direction from nearest town or city street address of well if located within city?
4 South & 1 East of Wetmore

2 WATER WELL OWNER: Michael Keehn
 RR#, St. Address, Box # : Rt. 1 Box 90 Board of Agriculture, Division of Water Resources
 City, State, ZIP Code : Wetmore, Kansas 66550 Application Number:

3 LOCATE WELL'S LOCATION WITH AN "X" IN SECTION BOX:

 4 DEPTH OF COMPLETED WELL... 100 ft. ELEVATION:
 Depth(s) Groundwater Encountered 1. ft. 2. ft. 3. ft.
 WELL'S STATIC WATER LEVEL... 70 ft. below land surface measured on mo/day/yr 4-19-02
 Pump test data: Well water was ft. after hours pumping gpm
 Est. Yield .. 8 gpm: Well water was ft. after hours pumping gpm
 Bore Hole Diameter... 10 in. to 100 ft., and in. to ft.
 WELL WATER TO BE USED AS: 5 Public water supply 8 Air conditioning 11 Injection well
1 Domestic 3 Feedlot 6 Oil field water supply 9 Dewatering 12 Other (Specify below)
 2 Irrigation 4 Industrial 7 Domestic (lawn & garden) 10 Monitoring well
 Was a chemical/bacteriological sample submitted to Department? Yes. No. X ; If yes, mo/day/yr sample was submitted
 Water Well Disinfected? Yes X No

5 TYPE OF BLANK CASING USED:
 1 Steel 3 RMP (SR) 5 Wrought iron 8 Concrete tile CASING JOINTS: Glued. X Clamped.
 2 PVC 4 ABS 6 Asbestos-Cement 9 Other (specify below) Welded.
 7 Fiberglass Threaded.
 Blank casing diameter 5 in. to 100 ft., Dia in. to ft., Dia in. to ft.
 Casing height above land surface. 24 in., weight 2.82 lbs./ft. Wall thickness or gauge No. 258
 TYPE OF SCREEN OR PERFORATION MATERIAL:
 1 Steel 3 Stainless steel 5 Fiberglass 7 PVC 10 Asbestos-cement
 2 Brass 4 Galvanized steel 6 Concrete tile 8 RMP (SR) 11 Other (specify)
 9 ABS 12 None used (open hole)
 SCREEN OR PERFORATION OPENINGS ARE:
 1 Continuous slot 3 Mill slot 5 Gauzed wrapped 8 Saw cut 11 None (open hole)
 2 Louvered shutter 4 Key punched 6 Wire wrapped 9 Drilled holes
 7 Torch cut 10 Other (specify) ft.
 SCREEN-PERFORATED INTERVALS: From. 71 ft. to 91 ft., From ft. to ft.
 From. ft. to ft., From ft. to ft.
 GRAVEL PACK INTERVALS: From. 24 ft. to 4 ft., From ft. to ft.
 From. ft. to ft., From ft. to ft.

6 GROUT MATERIAL: 1 Neat cement 2 Cement grout 3 Bentonite 4 Other
 Grout Intervals: From. 4 ft. to 24 ft., From ft. to ft., From ft. to ft.
 What is the nearest source of possible contamination:
 1 Septic tank 4 Lateral lines 7 Pit privy 10 Livestock pens 14 Abandoned water well
 2 Sewer lines 5 Cess pool 8 Sewage lagoon 11 Fuel storage 15 Oil well/Gas well
 3 Watertight sewer lines 6 Seepage pit 9 Feedyard 12 Fertilizer storage 16 Other (specify below)
 13 Insecticide storage
 Direction from well? Southwest How many feet? 300

FROM	TO	LITHOLOGIC LOG	FROM	TO	PLUGGING INTERVALS
0	1	top soil			
1	5	brown clay			
5	16	tan sandy clay			
16	21	yellow clay			
21	36	tan clay			
36	38	brown fine-coarse sand			
38	55	tan/yellow clay			
55	58	yellow clay/brown fine sand			
58	72	brown fine-coarse sand			
72	77	brown fine-coarse sand-pea gravel			
77	91	br.fine-coarse sand-pea-1/2 gravel			
91	100	grey/blue clay			

7 CONTRACTOR'S OR LANDOWNER'S CERTIFICATION: This water well was (1) constructed, (2) reconstructed, or (3) plugged under my jurisdiction and was completed on (mo/day/year) April 19, 2002 and this record is true to the best of my knowledge and belief. Kansas Water Well Contractor's Licence No. 182 This Water Well Record was completed on (mo/day/yr) April 24, 2002 under the business name of STRADER DRILLING CO. INC. by (signature) Michael Keehn