




Wetmore

11-5-14

~~VCS 088~~

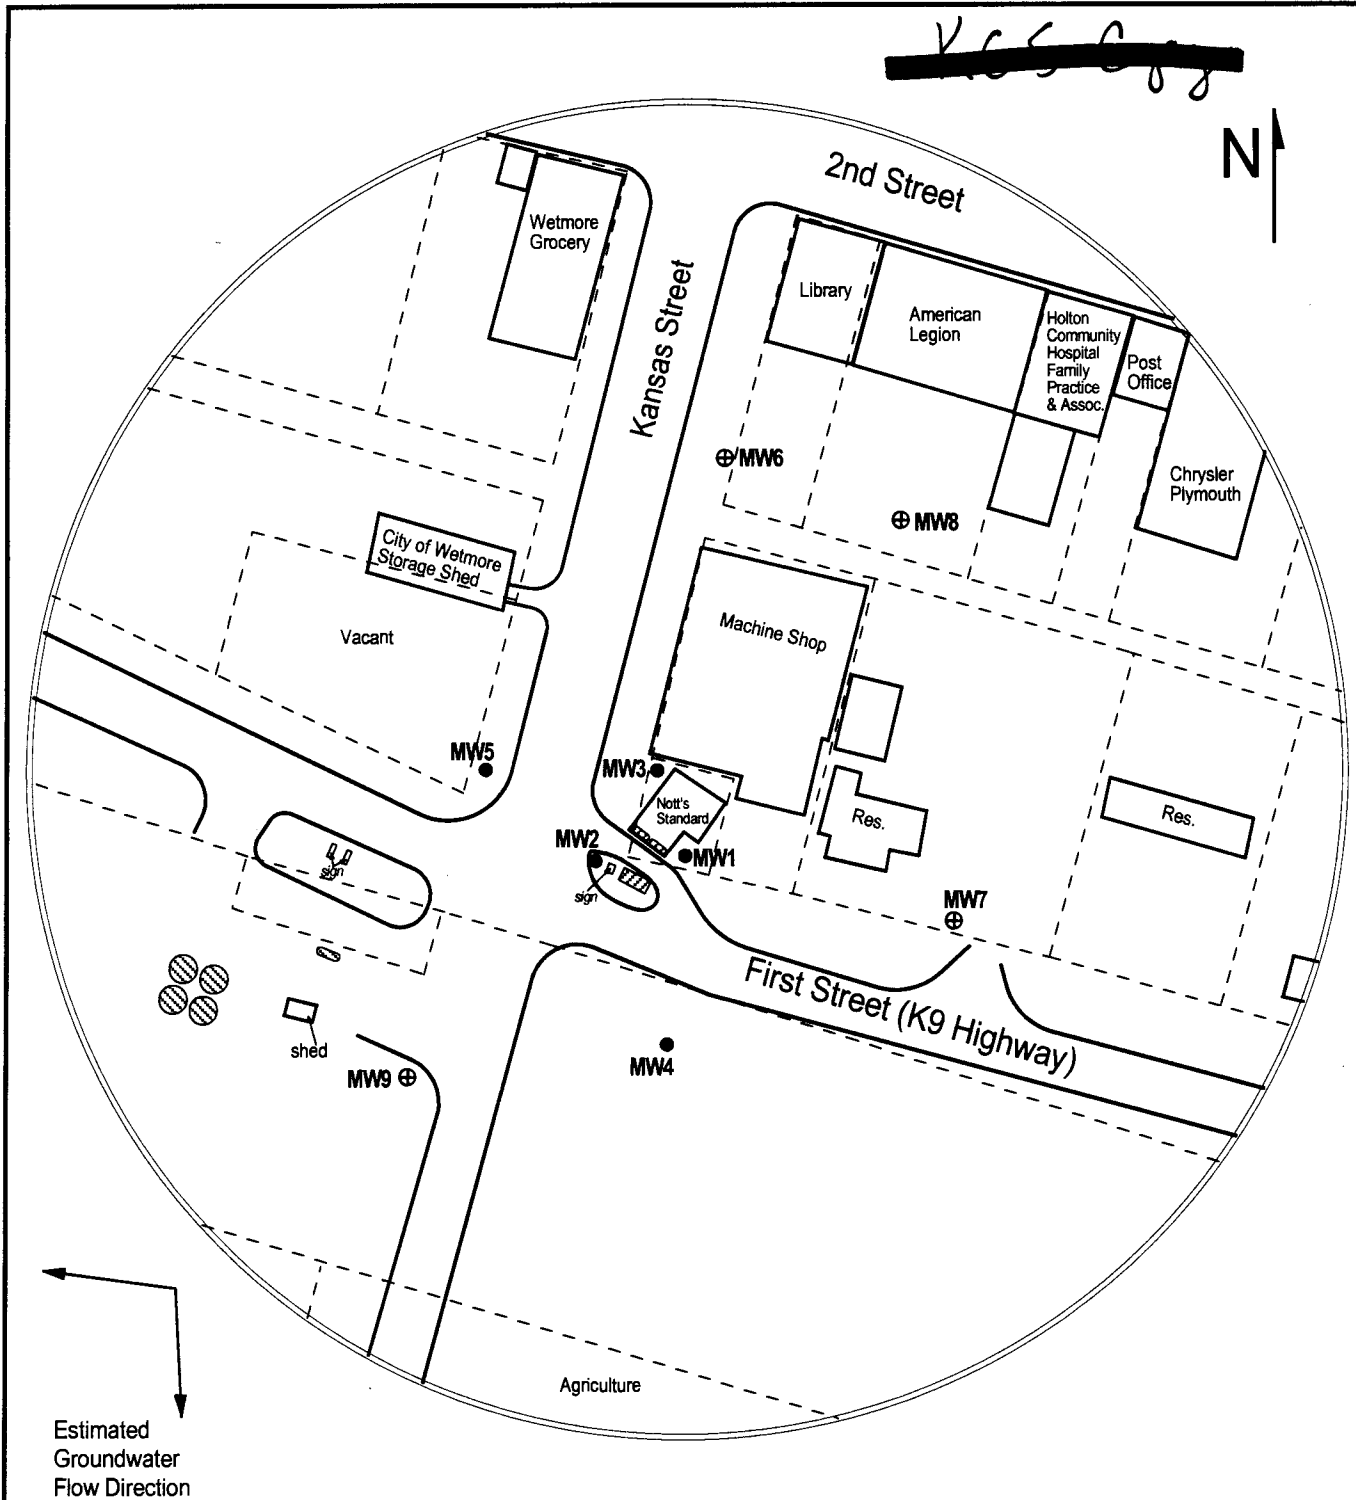

Estimated Groundwater Flow Direction

**LEGEND:**

- Approximate Location of Former UST Basin
- Approximate Location of Active AST and Pump Island
- Approximate Location of Property Line
- Monitoring Well
- Monitoring Well (Installed 3/4/14)



**PROJECT:**  
 Nott's Standard  
 1st & Kansas Ave  
 Wetmore, KS  
 KDHE ID: U4-066-12294  
 Date: 3/4/14



1311 E 25th St., Suite B (785) 841-8707 office  
 Lawrence, KS 66046 (785) 865-4282 fax

NOTE: Approximate location of active and former product lines are unknown.  
 NOTE: Monitoring wells have not been formerly surveyed by a licensed surveyor.  
 The top of casing elevation is based on an onsite benchmark.