


1 LOCATION OF WATER WELL: County: JACKSON Fraction SW 1/4 NE 1/4 SE 1/4 Section Number 4 Township Number T 5 S Range Number R 15 EW

Distance and direction from nearest town or city street address of well if located within city?  
2 3/8 north of Netawaka

2 WATER WELL OWNER: Larry Beam  
RR#, St. Address, Box #: 2100 NE 35th Board of Agriculture, Division of Water Resources  
City, State, ZIP Code: Topeka, KS 66617 Application Number:

3 LOCATE WELL'S LOCATION WITH AN "X" IN SECTION BOX:

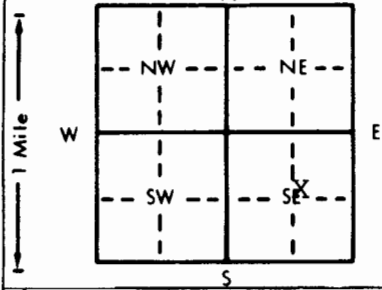

4 DEPTH OF COMPLETED WELL: 97' ft. ELEVATION:  
Depth(s) Groundwater Encountered 1. 64' ft. 2. ft. 3. ft.  
WELL'S STATIC WATER LEVEL: 33' ft. below land surface measured on mo/day/yr 11-18-92  
Pump test data: Well water was ft. after hours pumping gpm  
Est. Yield: 10 gpm: Well water was ft. after hours pumping gpm  
Bore Hole Diameter: 5" in. to ft. and in. to ft.  
WELL WATER TO BE USED AS:  
1 Domestic 2 Irrigation 3 Feedlot 4 Industrial 5 Public water supply 6 Oil field water supply 7 Lawn and garden only 8 Air conditioning 9 Dewatering 10 Monitoring well 11 Injection well 12 Other (Specify below)  
Was a chemical/bacteriological sample submitted to Department? Yes No X; If yes, mo/day/yr sample was submitted Water Well Disinfected? Yes X No

5 TYPE OF BLANK CASING USED:  
1 Steel 2 PVC 3 RMP (SR) 4 ABS 5 Wrought iron 6 Asbestos-Cement 7 Fiberglass 8 Concrete tile 9 Other (specify below) CASING JOINTS: Glued X Clamped Welded X Threaded

Blank casing diameter: 5" in. to 0-58 ft. Dia: 5" in. to 68-96 ft. Dia: in. to ft.  
Casing height above land surface: 24" in. weight: 2.82 lbs./ft. Wall thickness or gauge No.: 258

TYPE OF SCREEN OR PERFORATION MATERIAL:  
1 Steel 2 Brass 3 Stainless steel 4 Galvanized steel 5 Fiberglass 6 Concrete tile 7 PVC 8 RMP (SR) 9 ABS 10 Asbestos-cement 11 Other (specify) 12 None used (open hole)

SCREEN OR PERFORATION OPENINGS ARE:  
1 Continuous slot 2 Louvered shutter 3 Mill slot 4 Key punched 5 Gauzed wrapped 6 Wire wrapped 7 Torch cut 8 Saw cut 9 Drilled holes 11 None (open hole) 10 Other (specify)

SCREEN-PERFORATED INTERVALS:  
From 58 ft. to 68 ft. From ft. to ft.  
From 96 ft. to 97 ft. From ft. to ft.  
GRAVEL PACK INTERVALS:  
From 24 ft. to 97 ft. From ft. to ft.  
From ft. to ft. From ft. to ft.

6 GROUT MATERIAL: 1 Neat cement 2 Cement grout 3 Bentonite 4 Other  
Grout Intervals: From 4 ft. to 24 ft. From ft. to ft. From ft. to ft.

What is the nearest source of possible contamination:  
1 Septic tank 2 Sewer lines 3 Watertight sewer lines 4 Lateral lines 5 Cess pool 6 Seepage pit 7 Pit privy 8 Sewage lagoon 9 Feedyard 10 Livestock pens 11 Fuel storage 12 Fertilizer storage 13 Insecticide storage 14 Abandoned water well 15 Oil well/Gas well 16 Other (specify below)

Direction from well? north How many feet? 200'

FROM	TO	LITHOLOGIC LOG	FROM	TO	PLUGGING INTERVALS
0	1	Top Soil			
1	32	Clay-Brown			
32	33	Boulders			
33	58	Clay-Brown			
58	62	Fine Sand-Yellow			
62	64	FS-CS-Med-Pea Gravel 1/4x1/2-Brown			
64	66	Shale-Yellow			
66	80	Shale-Grey			
80	85	Limestone-Grey			
85	97	Shale-Grey			

7 CONTRACTOR'S OR LANDOWNER'S CERTIFICATION: This water well was (1) constructed, (2) reconstructed, or (3) plugged under my jurisdiction and was completed on (mo/day/year) 11-18-92 and this record is true to the best of my knowledge and belief. Kansas Water Well Contractor's License No. 182 This Water Well Record was completed on (mo/day/yr) 12-7-92 under the business name of STRADER DRILLING CO., INC. by (signature) Dale Strader

INSTRUCTIONS: Use typewriter or ball point pen. PLEASE PRESS FIRMLY and PRINT clearly. Please fill in blanks, underline or circle the correct answers. Send top three copies to Kansas Department of Health and Environment, Bureau of Water, Topeka, Kansas 66620-0001. Telephone: 913-296-5545. Send one to WATER WELL OWNER and retain one for your records.