41

USE TYPEWRITER OR BALL POINT PEN-PRESS FIRMLY, PRINT CLEARLY.

WATER WELL RECORD
KSA 82a-1201-1215

dba

Kansas Department of Health and Environment-Division of Environment
(Water well Contractors)
Topeka, Kansas 66620

1. Location of well:	County	Fraction	Section number	Township number	Range number
	Jackson	~~NE~~ NW SE ~~NE~~ 1/4	4	T 6 S	R 15 E/W

2. Distance and direction from nearest town or city: 3 N ½ W
Street address of well location if in city: Netawaka, Ks

3. Owner of well: Norman Shirley
R.R. or street: RR
City, state, zip code: Netawaka, Ks.

4. Locate with "X" in section below:

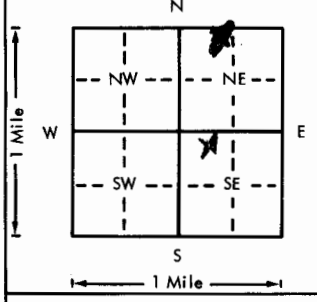

Sketch map: Hwy.

Ground Road

P.T silo

well → X ← 60

6. Bore hole dia. 8 in. Completion date
Well depth 85 ft. 8-30-77

7. ___ Cable tool X Rotary ___ Driven ___ Dug
___ Hollow rod ___ Jetted ___ Bored ___ Reverse rotary

8. Use: X Domestic ___ Public supply ___ Industry
___ Irrigation ___ Air conditioning ___ Stock
___ Lawn ___ Oil field water ___ Other

9. Casing: Material PVC Height: Above or below
Threaded ___ Welded ___ Surface 24 in.
RMP ___ PVC Glue Weight 2.74 lbs./ft.
Dia. 5 in. to 85 ft. depth Wall Thickness: inches or
Dia. ___ in. to ___ ft. depth gage No. 258

5. Type and color of material	From	To
Top Soil	0	2
Brown Clay	2	6
Brown Sandy Clay	6	16
Brown Clay	16	18
Gray Clay	18	52
Brown Clay	52	58
Brown Sandy Clay	58	74
Brown Clay	74	85

(Use a second sheet if needed)

10. Screen: Manufacturer's name Rumford
Type PVC Dia. 5"
Slot/gauze .020 Length 30
Set between 55 ft. and 85 ft.
___ ft. and ___ ft.
Gravel pack? X Size range of material .030-.060

11. Static water level: mo./day/yr.
68 ft. below land surface Date 8-31-77

12. Pumping level below land surfaces:
70 ft. after 2 hrs. pumping 15 g.p.m.
___ ft. after ___ hrs. pumping ___ g.p.m.
Estimated maximum yield 20 g.p.m.

13. Water sample submitted: mo./day/yr.
___ Yes X No Date

14. Well head completion: Top Cap
___ Pitless adapter 24 Inches above grade

15. Well grouted? Yes
With: X Neat cement ___ Bentonite ___ Concrete
Depth: From 0 ft. to 40 ft.

16. Nearest source of possible contamination: Pit
ft. 60 Direction N Type Silo
Well disinfected upon completion? X Yes ___ No

17. Pump: X Not installed
Manufacturer's name
Model number HP Volts
Length of drop pipe ft. capacity g.p.m.
Type:
___ Submersible ___ Turbine
___ Jet ___ Reciprocating
___ Centrifugal ___ Other

Elevation: 1140
graphy: Hill, Slope, Upland, Valley

19. Remarks: Owner to pour cement slab.

20. Water well contractor's certification:
This well was drilled under my jurisdiction and this report is true to the best of my knowledge and belief.
STrader Drlg Co 182
Business name License No.
Address RT 1 Holton, Ks
Signed Dale Askren Date 9-1-77
Authorized representative

T 6 S R 15 E/W Sec 4 NE 1/4 NW 1/4 NE 1/4

the white, blue and pink copies to the Department of Health and Environment

Form WWC-5

MI-1023

1051 < 1051