

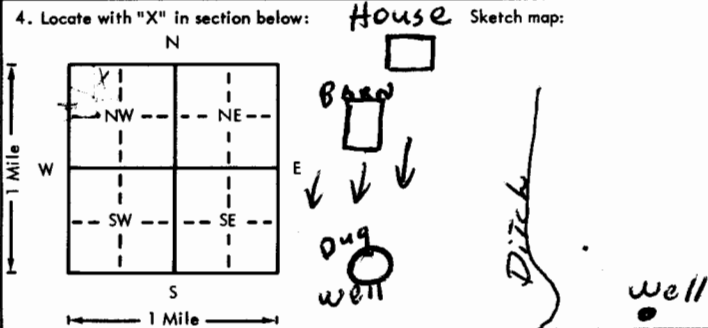
USE TYPEWRITER OR BALL POINT PEN-PRESS FIRMLY, PRINT CLEARLY.

WATER WELL RECORD
KSA 82a-1201-1215

Kansas Department of Health and Environment-Division of Environment
(Water well Contractors)
Topeka, Kansas 66620

lba

OF NW NW

1. Location of well: County <u>JACKSON</u> Fraction <u>SW 1/4 NW 1/4</u> Section number <u>11</u> Township number T <u>5</u> S <u>5</u> R <u>15</u> E <u>W</u>	
2. Distance and direction from nearest town or city: <u>2 No</u> Street address of well location if in city: <u>NETAWAKA, KS.</u>	
3. Owner of well: <u>Bill Hanzlicek</u> R.R. or street: <u>RR</u> City, state, zip code: <u>NETAWAKA, KS</u>	
4. Locate with "X" in section below: <u>House</u> Sketch map: 	
5. Type and color of material	
6. Bore hole dia. <u>10</u> in. Completion date <u>11-4-76</u> Well depth <u>120</u> ft.	
7. Cable tool <input checked="" type="checkbox"/> Rotary <input type="checkbox"/> Driven <input type="checkbox"/> Dug <input type="checkbox"/> Hollow rod <input type="checkbox"/> Jetted <input type="checkbox"/> Bored <input type="checkbox"/> Reverse rotary	
8. Use: <input checked="" type="checkbox"/> Domestic <input type="checkbox"/> Public supply <input type="checkbox"/> Industry <input type="checkbox"/> Irrigation <input type="checkbox"/> Air conditioning <input type="checkbox"/> Stock <input type="checkbox"/> Lawn <input type="checkbox"/> Oil field water <input type="checkbox"/> Other	
9. Casing: Material <u>PVC</u> Height: Above or below Threading: <input type="checkbox"/> Welded <input type="checkbox"/> Surface <u>24</u> in. RMP: <input type="checkbox"/> PVC <u>Blue</u> Weight <u>2.75</u> lbs./ft. Dia. <u>5</u> in. to <u>120</u> ft. depth Wall Thickness: inches or Dia. <u>5</u> in. to <u>120</u> ft. depth Gage No. <u>258</u>	
10. Screen: Manufacturer's name <u>Pump Co</u> Type <u>PVC</u> Dia. <u>5"</u> Slot <u>.025</u> Length <u>20</u> Set between <u>84</u> ft. and <u>104</u> ft. Gravel pack? <input checked="" type="checkbox"/> Size range of material <u>030-080</u>	
11. Static water level: <u>38</u> ft. below land surface Date <u>11-4-76</u> mo./day/yr.	
12. Pumping level below land surfaces: <u>Air Test</u> ft. after <u> </u> hrs. pumping <u> </u> g.p.m. Estimated maximum yield <u>100</u> g.p.m.	
13. Water sample submitted: <u> </u> mo./day/yr. <input checked="" type="checkbox"/> Yes <input type="checkbox"/> No Date <u> </u>	
14. Well head completion: <input checked="" type="checkbox"/> Pitless adapter <u>24</u> inches above grade	
15. Well grouted? <input checked="" type="checkbox"/> With: <input checked="" type="checkbox"/> Neat cement <input type="checkbox"/> Bentonite <input type="checkbox"/> Concrete Depth: From <u>4</u> ft. to <u>15</u> ft.	
16. Nearest source of possible contamination: <u>400</u> ft. Direction <u>NW</u> Type <u>BARNYD</u> Well disinfected upon completion? <input checked="" type="checkbox"/> Yes <input type="checkbox"/> No	
17. Pump: <input type="checkbox"/> Not installed Manufacturer's name <u>JAGUZZI</u> Model number <u>5548</u> HP <u>1/2</u> Volts <u>230</u> Length of drop pipe <u>100</u> ft. capacity <u>10</u> g.p.m. Type: <input checked="" type="checkbox"/> Submersible <input type="checkbox"/> Turbine <input type="checkbox"/> Jet <input type="checkbox"/> Reciprocating <input type="checkbox"/> Centrifugal <input type="checkbox"/> Other	
18. Elevation: <u>1070</u> Topography: <input type="checkbox"/> Hill <input type="checkbox"/> Slope <input type="checkbox"/> Upland <input checked="" type="checkbox"/> Valley	
19. Remarks: <u>owner to install slab</u>	
20. Water well contractor's certification: This well was drilled under my jurisdiction and this report is true to the best of my knowledge and belief. <u>STANDER DOLG CO INC 182</u> Business name License No. Address <u>RT 1 Holton, KS</u> Signed <u>Dale Robinson</u> Date <u>12-27-76</u> Authorized representative	

Forward the white, blue and pink copies to the Department of Health and Environment

Form WWC-5

elev 1032' 81234

ENVIRONMENTAL HEALTH LABORATORY

Results of Special Chemical Analyses

City Jackson County Shipper Dwight Brinkley Acct. Oil Field Lab. No. 77-837

Date Received 12-27-76

Date Reported JAN 05 1978 Bottle No. _____

SOURCE AND REMARKS:

SUNWWW

Copy to Dwight Brinkley

AJ New well belonging to Bill Hanzlicek ~~own~~, Sec 11, T5S, R15E. pumping level 85-87 feet. collected 12-27-76.

RESULTS EXPRESSED IN MILLIGRAMS PER LITER

Sp Cond	_____	pH	_____	Boron	_____
Total Solids	_____	Turbidity	_____	Copper	_____
T H (CaCO ₃)	<u>1300.</u>	Diss Oxygen	_____	Lead	_____
Calcium (Ca)	<u>318.</u>	5 day 20°C BOD	_____	Zinc	_____
Magnesium (Mg)	<u>122.</u>	Chem Oxy Demand	_____	Hex Chromium	_____
Sodium	<u>535.</u>	Phosphate (PO ₄)	_____	Cadmium	_____
Potassium	_____	Ammonia (N)	_____	Silver	_____
Alk (CaCO ₃)	<u>346</u>	Nitrite (N)	_____	Mercury	_____
Chloride	<u>520.</u>	Total Org N	_____	Arsenic	_____
Sulfate	<u>1330.</u>	Detergent (LAS)	_____		_____
Nitrate (NO ₃)	<u>0.1</u>	T Susp Solids	_____		_____
Fluoride	<u>0.6</u>	F Susp Solids	_____		_____
Total Iron	<u>2.1</u>	V Susp Solids	_____		_____
Manganese	<u>0.12</u>	Silica (SiO ₂)	_____		_____

ENVIRONMENTAL HEALTH LABORATORY

Results of Special Chemical Analyses

City Jackson County Shipper Dwight Brinkley Acct. Oil Field Lab. No. 77-836

Date Received 12-27-76

Date Reported JAN 05 1976 Bottle No. _____

SOURCE AND REMARKS:

Copy to: Dwight Brinkley

SWNNW

Old well belonging to Bill Hanzlicek. ~~C NW~~, Sec 11, T5S, R15E. well 30 feet deep, water level at 20 feet. collected 12-27-76.

RESULTS EXPRESSED IN MILLIGRAMS PER LITER

Sp Cond		pH		Boron	
Total Solids		Turbidity		Copper	
T H (CaCO ₃)	476	Diss Oxygen		Lead	
Calcium (Ca)	138	5 day 20°C BOD		Zinc	
Magnesium (Mg)	32	Chem Oxy Demand		Hex Chromium	
Sodium	21	Phosphate (PO ₄)		Cadmium	
Potassium		Ammonia (N)		Silver	
Alk (CaCO ₃)	278	Nitrite (N)		Mercury	
Chloride	84	Total Org N		Arsenic	
Sulfate	65	Detergent (LAS)			
Nitrate (NO ₃)	69	T Susp Solids			
Fluoride	0.6	F Susp Solids			
Total Iron	2.6	V Susp Solids			
Manganese	0.3	Silica (SiO ₂)			