

Plugging Report

USE TYPEWRITER OR BALL POINT PEN. PRESS FIRMLY, PRINT CLEARLY.

WATER WELL RECORD
KSA 82a-1201-1215

Kansas Department of Health and Environment
Division of Environment
(Water well Contractors)
Topeka, Kansas 66620

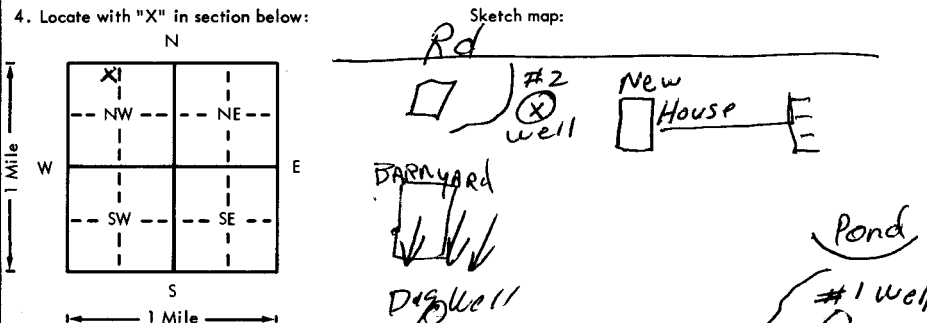
1. Location of well:	County: Jackson	Fraction: NW 1/4 NE 1/4 NW 1/4	Section number: 11	Township number: T 5 S R	Range number: 15 EW
2. Distance and direction from nearest town or city:	3 N.		3. Owner of well: Bill Hanzlicok	R.R. or street: _____	
Street address of well location if in city:	Netawaka, KS		City, state, zip code: Netawaka KS		
4. Locate with "X" in section below:	Sketch map: # 2 well		6. Bore hole dia. 10 in. Completion date: 4-11-77 DWB Well depth 103 ft.		
			7. Cable tool <input type="checkbox"/> Rotary <input type="checkbox"/> Driven <input type="checkbox"/> Dug <input type="checkbox"/> Hollow rod <input type="checkbox"/> Jetted <input type="checkbox"/> Bored <input type="checkbox"/> Reverse rotary <input type="checkbox"/>		
			8. Use: Domestic <input type="checkbox"/> Public supply <input type="checkbox"/> Industry <input type="checkbox"/> Irrigation <input type="checkbox"/> Air conditioning <input type="checkbox"/> Stock <input type="checkbox"/> Lawn <input type="checkbox"/> Oil field water <input type="checkbox"/> Other <input type="checkbox"/>		
5. Type and color of material	From	To	9. Casing: Material _____ Height: Above or below _____ Threaded _____ Welded _____ Surface _____ in. RMP _____ PVC _____ Weight _____ lbs./ft. Dia. _____ in. to _____ ft. depth Wall Thickness: inches or _____ Dia. _____ in. to _____ ft. depth gage No. _____		
Top Soil	0	4	10. Screen: Manufacturer's name _____ Type _____ Dia. _____ Slot/gauze _____ Length _____ Set between _____ ft. and _____ ft. _____ ft. and _____ ft. Gravel pack? _____ Size range of material _____		
Brown Clay	4	8	11. Static water level: _____ mo./day/yr. _____ ft. below land surface Date _____		
Brown sandy clay	8	27	12. Pumping level below land surfaces: _____ ft. after _____ hrs. pumping _____ g.p.m. _____ ft. after _____ hrs. pumping _____ g.p.m. Estimated maximum yield _____ g.p.m.		
Brown silty clay	27	38	13. Water sample submitted: Attached mo./day/yr. <input checked="" type="checkbox"/> Yes <input type="checkbox"/> No Date 1-31-77		
Brown sandy clay	38	43	14. Well head completion: <input type="checkbox"/> Pitless adapter _____ inches above grade		
Grey clay	43	87	15. Well grouted? <input type="checkbox"/> With: _____ Neat cement _____ Bentonite _____ Concrete _____ Depth: From _____ ft. to _____ ft.		
Grey med-coarse gravel	87	91	16. Nearest source of possible contamination: ft. _____ Direction _____ Type _____ Well disinfected upon completion? <input type="checkbox"/> Yes <input type="checkbox"/> No		
Grey clay	91	94	17. Pump: _____ Not installed Manufacturer's name _____ Model number _____ HP _____ Volts _____ Length of drop pipe _____ ft. capacity _____ g.p.m. Type: <input type="checkbox"/> Submersible <input type="checkbox"/> Turbine <input type="checkbox"/> Jet <input type="checkbox"/> Reciprocating <input type="checkbox"/> Centrifugal <input type="checkbox"/> Other		
Grey sandy clay	94	96	20. Water well contractor's certification: This well was drilled under my jurisdiction and this report is true to the best of my knowledge and belief. STRADER DOLG Co Inc 182 Business name _____ License No. _____ Address 271 Walton, KS Signed Dale Fisher Date 5-17-77 Authorized representative		
Grey 1/4" Gravel	96	102			
H1 Flat Gravel					
Red shale	102	103			
Grey shale	103	-			
4-11-77 (Use a second sheet if needed)					
18. Elevation:	19. Remarks: Hole Plugged with Neet cement 95'-103' casing Pulled Remaining Hole Filled w/clay				
Topography: <input checked="" type="checkbox"/> Hill <input type="checkbox"/> Slope <input type="checkbox"/> Upland <input type="checkbox"/> Valley					

T 5 S R
 W
 Sec 11
 NE 1/4 NW 1/4

USE TYPEWRITER OR BALL POINT PEN-PRESS FIRMLY, PRINT CLEARLY.

WATER WELL RECORD
KSA 82a-1201-1215

Kansas Department of Health and Environment-Division of Environment
(Water well Contractors)
Topeka, Kansas 66620

1. Location of well: County <u>JACKSON</u> Fraction <u>NW NE 1/4 NW 1/4 NW 1/4</u> Section number <u>11</u> Township number T <u>5</u> S R <u>15</u> E/W	
2. Distance and direction from nearest town or city: <u>3 N - 1/8 E,</u> Street address of well location if in city: <u>NE TAWAKA</u>	
3. Owner of well: <u>Bill Hanzlicek PR</u> City, state, zip code: <u>NE TAWAKA, KS</u>	
4. Locate with "X" in section below: Sketch map: 	
6. Bore hole dia. <u>10</u> in. Completion date <u>1-26-77</u> Well depth, <u>103</u> ft.	
7. <input type="checkbox"/> Cable tool <input checked="" type="checkbox"/> Rotary <input type="checkbox"/> Driven <input type="checkbox"/> Dug <input type="checkbox"/> Hollow rod <input type="checkbox"/> Jetted <input type="checkbox"/> Bored <input type="checkbox"/> Reverse rotary	
8. Use: <input checked="" type="checkbox"/> Domestic <input type="checkbox"/> Public supply <input type="checkbox"/> Industry <input type="checkbox"/> Irrigation <input type="checkbox"/> Air conditioning <input type="checkbox"/> Stock <input type="checkbox"/> Lawn <input type="checkbox"/> Oil field water <input type="checkbox"/> Other	
9. Casing: Material <u>PVC</u> Height: <input checked="" type="checkbox"/> Above or below Threading: <input type="checkbox"/> Welded <input type="checkbox"/> Surface <u>24</u> in. RMP: <input type="checkbox"/> PVC <u>Glue</u> Weight <u>2.75</u> lbs./ft. Dia. <u>5</u> in. to <u>103</u> ft. depth; Wall Thickness: inches or Dia. <u>5</u> in. to <u>103</u> ft. depth; gage No. <u>258</u>	
10. Screen: Manufacturer's name <u>Pump Co</u> Type <u>PVC</u> Dia. <u>5"</u> Slot/gauze <u>.025</u> Length <u>20</u> Set between <u>82</u> ft. and <u>102</u> ft. Gravel pack? <input checked="" type="checkbox"/> Size range of material: <u>20-40</u>	
11. Static water level: <u>60</u> ft. below land surface Date <u>1-27-77</u> mo./day/yr.	
12. Pumping level below land surfaces: <u>10</u> ft. after <u>1</u> hrs. pumping <u>30</u> g.p.m. Estimated maximum yield <u>30</u> g.p.m.	
13. Water sample submitted: <input checked="" type="checkbox"/> Yes <input type="checkbox"/> No Date _____ mo./day/yr.	
14. Well head completion: <u>CAP</u> Pitless adapter <u>24</u> inches above grade	
15. Well grouted? <u>NO</u> With: <input type="checkbox"/> Neat cement <input type="checkbox"/> Bentonite <input type="checkbox"/> Concrete Depth: From _____ ft. to _____ ft.	
16. Nearest source of possible contamination: ft. <u>100</u> Direction <u>E</u> Type <u>ARTESIAN</u> Well disinfected upon completion? <input checked="" type="checkbox"/> Yes <input type="checkbox"/> No	
17. Pump: <input checked="" type="checkbox"/> Not installed Manufacturer's name _____ Model number _____ HP _____ Volts _____ Length of drop pipe _____ ft. capacity _____ g.p.m. Type: <input type="checkbox"/> Submersible <input type="checkbox"/> Turbine <input type="checkbox"/> Jet <input type="checkbox"/> Reciprocating <input type="checkbox"/> Centrifugal <input type="checkbox"/> Other	
18. Elevation: Topography: <input checked="" type="checkbox"/> Hill <input type="checkbox"/> Slope <input type="checkbox"/> Upland <input type="checkbox"/> Valley	
19. Remarks: <u>(SAIT WATER !!)</u> <u>Casing Pitted - cemented & hole plugged in</u> <u>This Report Ammends Previous Report</u>	
20. Water well contractor's certification: This well was drilled under my jurisdiction and this report is true to the best of my knowledge and belief. Business name <u>STRADEE Dehq Co Inc</u> License No. <u>182</u> Address <u>RT 1 Holton, KS</u> Signed <u>Dale Ashen</u> Date <u>4-26-77</u> Authorized representative	

5 15 11 NE NW NW
 T R W E Sec
 1/4 1/4 1/4 1/4

ENVIRONMENTAL HEALTH LABORATORY

REPORT

Results of Special Chemical Analyses

City Jackson County Shipper Dwight Brinkley Acct. Oil Field Lab. No. 7

Date Received 1-31-77

Date Reported FEB 10 1977 Bottle 1
Copy to: Dwight Brinkley

SOURCE AND REMARKS:

Bill Hanzlicek, Netawaka. New test hole west of new home. ^{NE} NW, NW, NW Sec 11-5-15E.
collected 1-31-77.

RESULTS EXPRESSED IN MILLIGRAMS

Sp Cond	pH	Boron
Total Solids	Turbidity	Copper
T H (CaCO ₃) ✓ 1670.	Diss Oxygen	Lead
Calcium (Ca) ✓ 414.	5 day 20°C BOD	Zinc
Magnesium (Mg) ✓ 156.	Chem Oxy Demand	Hex Chromium
Sodium ✓ 230.	Phosphate (PO ₄)	Cadmium
Potassium	Ammonia (N)	Silver
Alk (CaCO ₃) ✓ 306.	Nitrite (N)	Mercury
Chloride ✓ 73.	Total Org N	Arsenic
Sulfate ✓ 1690.	Detergent (LAS)	
Nitrate (NO ₃) ✓ 0.1	T Susp Solids	
Fluoride ✓ 0.7	F Susp Solids	
Total Iron ✓ 4.6	V Susp Solids	
Manganese ✓ 0.51	Silica (SiO ₂)	