

5

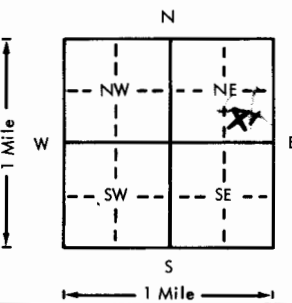
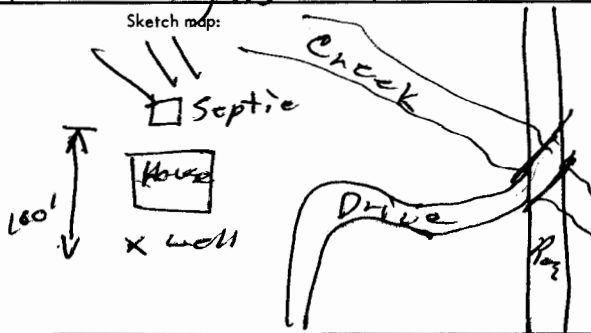
VBRT

USE TYPEWRITER OR BALL POINT PEN-PRESS FIRMLY, PRINT CLEARLY.

WATER WELL RECORD
KSA 82a-1201-1215

Kansas Department of Health and Environment-Division of Environment
(Water well Contractors)
Topeka, Kansas 66620

adc

1. Location of well:		County Jackson	Fraction SW 1/4 SE 1/4 NE 1/4	Section number 29	Township number T 5 S	Range number R 15 E	
2. Distance and direction from nearest town or city: 2 W 1/2 S Street address of well location if in city: Netawaka, KS				3. Owner of well: Glen Oxendale R.R. or street: RR City, state, zip code: Wetmore, Kansas			
4. Locate with "X" in section below: 				Sketch map: 		6. Bore hole dia. 10 in. Completion date _____ Well depth 122 ft. 7-21-77	
5. Type and color of material				From	To	7. <input checked="" type="checkbox"/> Cable tool <input checked="" type="checkbox"/> Rotary <input type="checkbox"/> Driven <input type="checkbox"/> Dug <input type="checkbox"/> Hollow rod <input type="checkbox"/> Jetted <input type="checkbox"/> Bored <input type="checkbox"/> Reverse rotary	
Top Soil				0	3	8. Use: <input checked="" type="checkbox"/> Domestic <input type="checkbox"/> Public supply <input type="checkbox"/> Industry <input type="checkbox"/> Irrigation <input type="checkbox"/> Air conditioning <input type="checkbox"/> Stock <input type="checkbox"/> Lawn <input type="checkbox"/> Oil field water <input type="checkbox"/> Other	
Brown Clay				3	5	9. Casing: Material PVC Height: Above or below Threaded <input type="checkbox"/> Welded <input type="checkbox"/> Surface 24 in. RMP <input type="checkbox"/> PV Blue Weight 2.74 lbs./ft. Dia. 5 in. to 122 ft. depth Wall Thickness: inches or Dia. _____ in. to _____ ft. depth gage No. 258	
Brown Fine Sand				5	12	10. Screen: Manufacturer's name PUMPRO Type PVC Dia. 5" Slot/gauze 20/22 Length 15 Set between 42 ft. and 52 ft. 117 ft. and 122 ft. Gravel pack? <input checked="" type="checkbox"/> Size range of material 20/60 #	
Brown Silty Clay				12	15	11. Static water level: _____ mo./day/yr. 35 ft. below land surface Date 7-21-77	
Brown med. Gravel				15	23	12. Pumping level below land surfaces: Art test _____ ft. after _____ hrs. pumping _____ g.p.m. _____ ft. after _____ hrs. pumping _____ g.p.m. Estimated maximum yield 20 @ 50 / 50 @ 122 g.p.m.	
Brown Silty Clay				23	33	13. Water sample submitted: _____ mo./day/yr. Yes <input type="checkbox"/> No <input checked="" type="checkbox"/> Date _____	
Brown Fine Sand				33	37	14. Well head completion: Top Cap <input type="checkbox"/> Pitless adapter 24 inches above grade	
Tan Sandy Clay				37	42	15. Well grouted? <input checked="" type="checkbox"/> Yes With: <input checked="" type="checkbox"/> Neat cement <input type="checkbox"/> Bentonite <input type="checkbox"/> Concrete Depth: From 5 ft. to 15 ft.	
Yellow-Brown Red Gravel				42	50	16. Nearest source of possible contamination: ft. 100 Direction N Type lot 15 Well disinfected upon completion? <input checked="" type="checkbox"/> Yes <input type="checkbox"/> No	
Tan Clay				50	53	17. Pump: _____ Not installed Manufacturer's name _____ Model number _____ HP _____ Volts _____ Length of drop pipe _____ ft. capacity _____ g.p.m. Type: <input type="checkbox"/> Submersible <input type="checkbox"/> Turbine <input type="checkbox"/> Jet <input type="checkbox"/> Reciprocating <input type="checkbox"/> Centrifugal <input type="checkbox"/> Other	
Gray Silty Clay				53	89	20. Water well contractor's certification: This well was drilled under my jurisdiction and this report is true to the best of my knowledge and belief. STRADER DRILY Co Inc 182 Business name License No. Address WATSON, KS Signed Dale Gibson Date 7-22-77 Authorized representative	
Black Clay				89	90		
Gray Silty Clay (Sugar Fine Sand)				90	110		
Gray Sugar to med Sand				110	114		
Gray & Brown Creek Gravel				114	122		
(Use a second sheet if needed)							
18. Elevation: 1870 Topography: <input checked="" type="checkbox"/> Hill <input type="checkbox"/> Slope <input type="checkbox"/> Upland <input type="checkbox"/> Valley		19. Remarks: Owner will pour cement slab around well					

T 5 S R 15 E Sec 29 SW SE NE 1/4 1/4 1/4