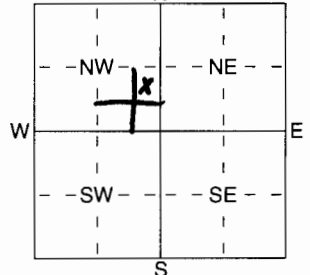


1 LOCATION OF WATER WELL: Fraction NE 1/4 SE 1/4 NW 1/4 Section Number 34 Township Number T 5 S Range Number R 15 E
 County: Jackson

Distance and direction from nearest town or city street address of well if located within city?
6 1/2 North of Holton

2 WATER WELL OWNER: Carl Reiff
 RR#, St. Address, Box #: 2950 Board of Agriculture, Division of Water Resources
 City, State, ZIP Code: US 75 Netawaka, KS 66516 Application Number: 45923

3 LOCATE WELL'S LOCATION WITH AN "X" IN SECTION BOX:

 4 DEPTH OF COMPLETED WELL 73 ft. ELEVATION: _____
 Depth(s) Groundwater Encountered 1 36 ft. 2 66 ft. 3 _____ ft.
 WELL'S STATIC WATER LEVEL 15' ft. below land surface measured on mo/day/yr 7-21-2004
 Pump test data: Well water was 35 ft. after 4 hours pumping 500 gpm
 Est. Yield 500+ gpm: Well water was _____ ft. after _____ hours pumping _____ gpm
 WELL WATER TO BE USED AS: 5 Public water supply 8 Air conditioning 11 Injection well
 1 Domestic 3 Feedlot 6 Oil field water supply 9 Dewatering 12 Other (Specify below)
2 Irrigation 4 Industrial 7 Domestic (lawn & garden) 10 Monitoring well
 Was a chemical/bacteriological sample submitted to Department? Yes _____ No X; If yes, mo/day/yr sample was submitted
 Water Well Disinfected? Yes X No _____

5 TYPE OF BLANK CASING USED:
 1 Steel 3 RMP (SR) 5 Wrought iron 8 Concrete tile CASING JOINTS: Glued _____ Clamped _____
2 PVC 4 ABS 6 Asbestos-Cement 9 Other (specify below) Welded _____
 7 Fiberglass Threaded _____
 Blank casing diameter _____ in. to 16 in. to 36 ft., Dia 16 in. to 66 ft., Dia _____ in. to _____ ft.
 Casing height above land surface 18 in., weight 15.54 lbs./ft. Wall thickness or gauge No. .500
 TYPE OF SCREEN OR PERFORATION MATERIAL:
 1 Steel 3 Stainless Steel 66-73 5 Fiberglass 7 PVC 36-41 10 Asbestos-Cement
 2 Brass 4 Galvanized Steel 6 Concrete tile 8 RMP (SR) 11 Other (Specify) _____
 9 ABS 12 None used (open hole)
 SCREEN OR PERFORATION OPENINGS ARE:
 1 Continuous slot 3 Mill slot 5 Gauzed wrapped 8 Saw cut 36-41 11 None (open hole)
6 Wire wrapped 66-73 9 Drilled holes
 2 Louvered shutter 4 Key punched 7 Torch cut 10 Other (specify) _____ ft.
 SCREEN-PERFORATED INTERVALS: From 36 ft. to 41 P14 ft., From _____ ft. to _____ ft.
 From 66 ft. to 73 SS ft., From _____ ft. to _____ ft.
 GRAVEL PACK INTERVALS: From _____ ft. to _____ ft., From _____ ft. to _____ ft.
 From 20 ft. to 73 ft., From _____ ft. to _____ ft.

6 GROUT MATERIAL: 1 Neat cement 2 Cement grout 3 Bentonite 4 Other _____
 Grout Intervals: From 0 ft. to 20 ft., From _____ ft. to _____ ft., From _____ ft. to _____ ft.
 What is the nearest source of possible contamination:
 1 Septic tank 4 Lateral lines 7 Pit privy 10 Livestock pens 14 Abandoned water well
 2 Sewer lines 5 Cess pool 8 Sewage lagoon 11 Fuel storage 15 Oil well/Gas well
 3 Watertight sewer lines 6 Seepage pit 9 Feedyard 12 Fertilizer storage 16 Other (specify below)
 13 Insecticide storage
 Direction from well? West How many feet? 200'

FROM	TO	LITHOLOGIC LOG	FROM	TO	PLUGGING INTERVALS
0	5	Topsoil			
5	18	Brown Clay			
18	21	Fine grey sand			
21	26	Fine/coarse/Med P / Grey-Brown			
26	27	Coarse to 3/8 P Grey-Brown			
27	29	Grey Sandy Clay			
29	43	Fine/coarse/to 3/8 P Grey-Brown			
43	64	Fine grey sand			
64	73	Fine/coarse/P/ 3/8, 1/2, 3/4 Grey Brown			
73	80	grey Sandy Clay			

7 CONTRACTOR'S OR LANDOWNER'S CERTIFICATION: This water well was (1) constructed, (2) reconstructed, or (3) plugged under my jurisdiction and was completed on (mo/day/year) 7-21-2004 and this record is true to the best of my knowledge and belief. Kansas Water Well Contractor's Licence No 182 This Water Well Record was completed on (mo/day/yr) 7-28-2008 under the business name of Strader Drilling Co. Inc. by (signature) [Signature]