

76

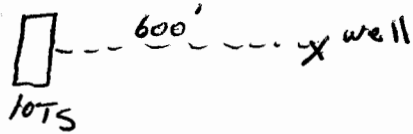
VIBRT

USE TYPEWRITER OR BALL POINT PEN-PRESS FIRMLY, PRINT CLEARLY.

WATER WELL RECORD
KSA 82a-1201-1215

Kansas Department of Health and Environment-Division of Environment
(Water well Contractors)
Topeka, Kansas 66620

aaa

1. Location of well: County JACKSON		Fraction NE 1/4 NE 1/4 NE 1/4		Section number 7		Township number T 5 S		Range number R 16 E			
2. Distance and direction from nearest town or city: 2 W 2.7				3. Owner of well: CLARENCE JONES							
Street address of well location if in city: N OF WHITTING				R.R. or street: WHITTING, KS							
4. Locate with "X" in section below: N W E S 1 Mile				Sketch map: 		6. Bore hole dia. 10 in. Completion date _____ Well depth 99 ft. 3-2-77					
5. Type and color of material				From		To		7. <input type="checkbox"/> Cable tool <input checked="" type="checkbox"/> Rotary <input type="checkbox"/> Driven <input type="checkbox"/> Dug <input type="checkbox"/> Hollow rod <input type="checkbox"/> Jetted <input type="checkbox"/> Bored <input type="checkbox"/> Reverse rotary			
								8. Use: <input checked="" type="checkbox"/> Domestic <input type="checkbox"/> Public supply <input type="checkbox"/> Industry <input type="checkbox"/> Irrigation <input type="checkbox"/> Air conditioning <input type="checkbox"/> Stock <input type="checkbox"/> Lawn <input type="checkbox"/> Oil field water <input type="checkbox"/> Other			
								9. Casing: Material PVC Height: Above or below Threaded _____ Welded _____ Surface 24 in. RMP _____ PVC 9L Weight 2.58 lbs./ft. Dia. 5 in. to 99 ft. depth Wall Thickness: inches or Dia. _____ in. to _____ ft. depth gage No. 258			
								10. Screen: Manufacturer's name _____ PUMPCO Type PVC Dia. 5 Slot/gauze .020 Length 10 Set between 26 ft. and 36 ft. _____ ft. and _____ ft. Gravel pack? <input checked="" type="checkbox"/> Size range of material .030x.060			
								11. Static water level: _____ mo./day/yr. 10 ft. below land surface Date 3-2-77			
								12. Pumping level below land surfaces: _____ ft. after _____ hrs. pumping _____ g.p.m. _____ ft. after _____ hrs. pumping _____ g.p.m. Estimated maximum yield 30 g.p.m.			
								13. Water sample submitted: _____ mo./day/yr. Yes <input type="checkbox"/> No <input checked="" type="checkbox"/> Date _____			
								14. Well head completion: CAP _____ Pitless adapter 24 inches above grade			
								15. Well grouted? <input checked="" type="checkbox"/> With: <input checked="" type="checkbox"/> Neat cement _____ Bentonite _____ Concrete _____ Depth: From 5 ft. to 15 ft.			
								16. Nearest source of possible contamination: ft. 600 Direction W Type LOTS Well disinfected upon completion? <input checked="" type="checkbox"/> Yes _____ No _____			
								17. Pump: <input checked="" type="checkbox"/> Not installed Manufacturer's name _____ Model number _____ HP _____ Volts _____ Length of drop pipe _____ ft. capacity _____ g.p.m. Type: <input type="checkbox"/> Submersible <input type="checkbox"/> Turbine <input type="checkbox"/> Jet <input type="checkbox"/> Reciprocating <input type="checkbox"/> Centrifugal <input type="checkbox"/> Other			
								20. Water well contractor's certification: This well was drilled under my jurisdiction and this report is true to the best of my knowledge and belief. Strader Dalg Co Inc. 182 Business name License No. Address RT1 WATTON, KS Signed Dale Robinson Date 3-6-77 Authorized representative			
18. Elevation: 1040		19. Remarks: OWNER WILL INSTAL SLAB									

T-5
R-16
S-7
NE NE NE
1/4 1/4 1/4

BR=1007
E=1030