95

VBRT
VID

USE TYPEWRITER OR BALL POINT PEN-PRESS FIRMLY, PRINT CLEARLY.

WATER WELL RECORD
KSA 82a-1201-1215

Kansas Department of Health and Environment-Division of Environment
(Water well Contractors)
Topeka, Kansas 66620

DBC

1. Location of well:	County	Fraction	Section number	Township number	Range number
	Jackson	SW 1/4 NW 1/4 SE 1/4	10	T 5 S	R 16 (E) W

2. Distance and direction from nearest town or city: 2 1/4 N

Street address of well location if in city: Whiting

3. Owner of well: City of Whiting

R.R. or street:

City, state, zip code: Whiting, Kansas

4. Locate with "X" in section below:

N — NW — NE — W — E — SW — X — SE — S — 1 Mile — 1 Mile

Sketch map:

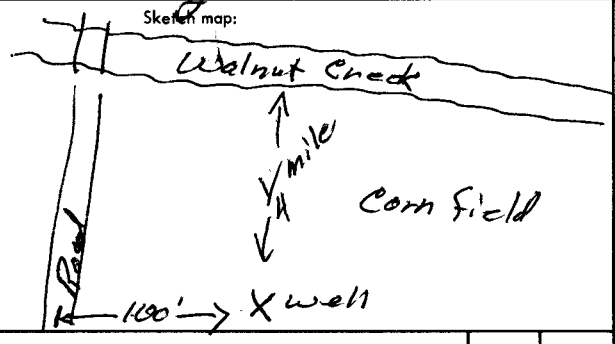

6. Bore hole dia. 12 in. Completion date 7-19-77
Well depth 52 ft.

7. __ Cable tool X Rotary __ Driven __ Dug
__ Hollow rod __ Jetted __ Bored __ Reverse rotary

8. Use: __ Domestic X Public supply __ Industry
__ Irrigation __ Air conditioning __ Stock
__ Lawn __ Oil field water __ Other

9. Casing: Material PVC Height Above or below
Threaded ___ Welded ___ Surface 24 in.
RMP ___ PVC Glue Weight 3.58 lbs./ft.
Dia. 6 in. to 42 ft. depth Wall Thickness: inches or
Dia. ___ in. to ___ ft. depth gage No. .280

5. Type and color of material	From	To
Top Soil	0	3
Black loam	3	6
Gray Clay	6	24
Gray Silty Clay w/med Sand	24	40
Gray Coarse Sand to Pea Gravel	40	48
Gray Shale	48	49
Gray Limestone	49	52

(Use a second sheet if needed)

10. Screen: Manufacturer's name Johnson
Type Stainless Steel Dia. 6"
Slot/gauze .080 Length 10
Set between 42 ft. and 52 ft.
___ ft. and ___ ft.
Gravel pack? YES Size range of material 1/4 - 1/8

11. Static water level: mo./day/yr.
14 ft. below land surface Date 7-19-77

12. Pumping level below land surfaces: Air Test
___ ft. after ___ hrs. pumping ___ g.p.m.
___ ft. after ___ hrs. pumping ___ g.p.m.
Estimated maximum yield 42 g.p.m.

13. Water sample submitted: mo./day/yr.
✓ Yes ___ No Date 7-27-77

14. Well head completion: Top
___ Pitless adapter ___ Inches above grade

15. Well grouted? YES
With: X Neat cement ___ Bentonite ___ Concrete
Depth: From 0 ft. to 20 ft.

16. Nearest source of possible contamination:
ft. 1/4 mi. Direction N Type Creek
Well disinfected upon completion? X Yes ___ No

17. Pump: ___ Not installed
Manufacturer's name Jacuzzi
Model number 3S4C HP 3 Volts 230
Length of drop pipe 50 ft. capacity 20 g.p.m.
Type:
✓ Submersible ___ Turbine
___ Jet ___ Reciprocating
___ Centrifugal ___ Other

T 5 R 16 (E) W Sec 10 1/4 1/4 1/4 SW/SE

18. Elevation: 987 ±25
Topography:
___ Hill
___ Slope
___ Upland
X Valley

19. Remarks:

20. Water well contractor's certification:
This well was drilled under my jurisdiction and this report is true to the best of my knowledge and belief.
Business name Strader Drlg Co Inc. License No. 182
Address RT 1 Holton, KS
Signed Dale Gabson Date 7-26-77
Authorized representative

Forward the white, blue and pink copies to the Department of Health and Environment

Form WWC-5

BR = 939 ▽ = 973

VDA