


1 LOCATION OF WATER WELL: Fraction NE 1/4 NW 1/4 NE 1/4 Section Number 15 Township Number T 5 S Range Number R 16 E/W
 County: JACKSON

Distance and direction from nearest town or city street address of well if located within city?
 2 miles north, .4 mile east of Whiting

2 WATER WELL OWNER: City of Whiting
 RR#, St. Address, Box #: Whiting, Kansas 66552 WELL #6 Board of Agriculture, Division of Water Resources
 City, State, ZIP Code: Whiting, Kansas 66552 Application Number:

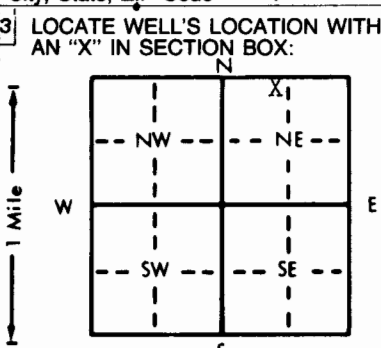

4 DEPTH OF COMPLETED WELL: 40 ft. ELEVATION:
 Depth(s) Groundwater Encountered 1. 15 ft. 2. ft. 3. ft.
 WELL'S STATIC WATER LEVEL: 10 ft. below land surface measured on mo/day/yr 9-19-85
 Pump test data: Well water was ft. after hours pumping gpm
 Est. Yield: 80 gpm: Well water was ft. after hours pumping gpm
 Bore Hole Diameter: 12 in. to ft. and in. to ft.
 WELL WATER TO BE USED AS:
 5 Public water supply 8 Air conditioning 11 Injection well
 1 Domestic 3 Feedlot 6 Oil field water supply 9 Dewatering 12 Other (Specify below)
 2 Irrigation 4 Industrial 7 Lawn and garden only 10 Observation well
 Was a chemical/bacteriological sample submitted to Department? Yes X No; If yes, mo/day/yr sample was submitted 10-01-85
 Water Well Disinfected? Yes X No

5 TYPE OF BLANK CASING USED:
 1 Steel 3 RMP (SR) 6 Asbestos-Cement 9 Other (specify below)
 2 PVC 4 ABS 7 Fiberglass
 Blank casing diameter: 6 in. to 0-20 ft., Dia. 6 in. to 26-40 ft., Dia.
 Casing height above land surface: 36 in., weight 18.97 lbs./ft. Wall thickness or gauge No. 280
 TYPE OF SCREEN OR PERFORATION MATERIAL:
 1 Steel 3 Stainless steel 5 Fiberglass 8 RMP (SR)
 2 Brass 4 Galvanized steel 6 Concrete tile 9 ABS 12 None used (open hole)
 SCREEN OR PERFORATION OPENINGS ARE:
 1 Continuous slot 3 Mill slot JOHNSON SS - 5 Gauzed wrapped 8 Saw cut 11 None (open hole)
 2 Louvered shutter 4 Key punched 020 6 Wire wrapped 9 Drilled holes
 7 Torch cut 10 Other (specify)
 SCREEN-PERFORATED INTERVALS: From 20 ft. to 26 ft., From ft. to ft.
 GRAVEL PACK INTERVALS: From 15 ft. to 40 ft., From ft. to ft.

6 GROUT MATERIAL: 1 Neat cement 2 Cement grout 3 Bentonite 4 Other
 Grout Intervals: From 0 ft. to 15 ft., From ft. to ft., From ft. to ft.
 What is the nearest source of possible contamination:
 1 Septic tank 4 Lateral lines 7 Pit privy 10 Livestock pens 14 Abandoned water well
 2 Sewer lines 5 Cess pool 8 Sewage lagoon 11 Fuel storage 15 Oil well/Gas well
 3 Watertight sewer lines 6 Seepage pit 9 Feedyard 12 Fertilizer storage 16 Other (specify below)
 13 Insecticide storage
 Direction from well? W How many feet? 600

FROM	TO	LITHOLOGIC LOG	FROM	TO	LITHOLOGIC LOG
0	3	top soil			
3	10	silty sand brown			
10	15	fs-brown			
15	16	fs-cs-med-gravel, brown			
16	18	blnds. loose			
18	40	shale grey			

7 CONTRACTOR'S OR LANDOWNER'S CERTIFICATION: This water well was (1) constructed, (2) reconstructed, or (3) plugged under my jurisdiction and was completed on (mo/day/year) 9-19-85 and this record is true to the best of my knowledge and belief. Kansas Water Well Contractor's License No. 182 This Water Well Record was completed on (mo/day/yr) 12-10-85 under the business name of Strader Drlg. Co., Inc. by (signature) Dale Astren

INSTRUCTIONS: Use typewriter or ball point pen, PLEASE PRESS FIRMLY and PRINT clearly. Please fill in blanks, underline or circle the correct answers. Send top three copies to Kansas Department of Health and Environment, Division of Environment, Environmental Geology Section, Topeka, KS 66620. Send one to WATER WELL OWNER and retain one for your records.