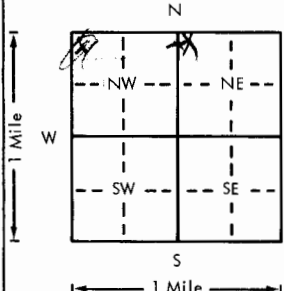
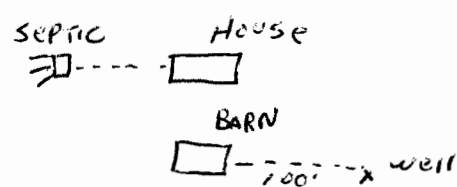


USE TYPEWRITER OR BALL
POINT PEN—PRESS FIRMLY,
PRINT CLEARLY.

WATER WELL RECORD
KSA 82a-1201-1215

Kansas Department of Health and
Environment—Division of Environment
(Water well Contractors)
Topeka, Kansas 66620

Location of well:	County	Fraction	Section number	Township number	Range number
1. Location of well:	BROWN	NW 1/4 NW 1/4 NE 1/4	13	T 5 S R 17	W
2. Distance and direction from nearest town or city: 4 S. 3 E. 5 N		3. Owner of well: ALBERT 2 W UNIT 2 ER			
Street address of well location if in city: OF HORTON		R.R. or street: HORTON RRI			
City, state, zip code: HORTON RRI					
4. Locate with "X" in section below:		Sketch map:		6. Bore hole dia. 10 in. Completion date 2-28-77	
				Well depth 105 ft.	
5. Type and color of material		From	To	7. Cable tool Rotary Driven Dug Hollow rod Jetted Bored Reverse rotary	
Top soil		0	5	8. Use: Domestic Public supply Industry Irrigation Air conditioning Stock Lawn Oil field water Other	
Clay, yellow		5	60	9. Casing: Material PVC Height: Above or below Threaded Welded Surface 24 in. RMP PVC 94 Weight 2.58 lbs./ft. Dia. 5 in. to 105 ft. depth Wall Thickness: inches or Dia. in. to ft. depth gage No. 2.74	
Coarse sand		60	65	10. Screens: Manufacturer's name Type PVC Dia. 5 Slot/gauze 1020 Length 30 Set between 60 ft. and 80 ft. Gravel pack? Size range of material 10 to 100	
Shale, grey		65	105	11. Static water level: mo./day/yr. 60 ft. below land surface Date 2-28-77	
				12. Pumping level below land surfaces: AINTEST ft. after hrs. pumping g.p.m. ft. after hrs. pumping g.p.m. Estimated maximum yield 3 g.p.m.	
				13. Water sample submitted: mo./day/yr. Yes No Date	
				14. Well head completion: 54 P Pitless adapter 24 Inches above grade	
				15. Well grouted? Not installed With: Neat cement Bentonite Concrete Depth: From 5 ft. to 15 ft.	
				16. Nearest source of possible contamination: ft. 100 Direction W Type 10TS Well disinfected upon completion? Yes No	
				17. Pump: Not installed Manufacturer's name Model number HP Volts Length of drop pipe ft. capacity g.p.m. Type: Submersible Turbine Jet Reciprocating Centrifugal Other	
18. Elevation: 1121		19. Remarks: OWNER WILL INSTALL SIAB		20. Water well contractor's certification: This well was drilled under my jurisdiction and this report is true to the best of my knowledge and belief. STADLER DRILL CO. INC. 182 Business name License No. Address RR #1 HORTON, KS Signed Gary Johnson Date 3-2-77 Authorized representative	