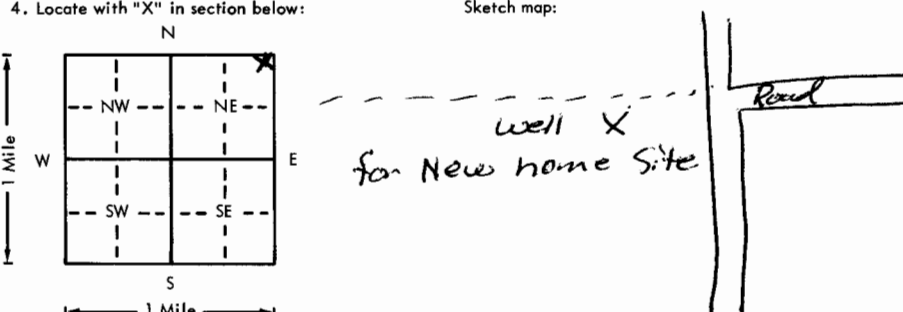


USE TYPEWRITER OR BALL
POINT PEN-PRESS FIRMLY,
PRINT CLEARLY.

WATER WELL RECORD
KSA 82a-1201-1215

Kansas Department of Health and
Environment-Division of Environment
(Water well Contractors)
Topeka, Kansas 66620

1. Location of well: County <u>Atchison</u> Fraction <u>NE 1/4 NE 1/4 NE 1/4</u> Section number <u>36</u> Township number <u>T 5 S R 17 E</u> Range number <u>17</u>	
2. Distance and direction from nearest town or city: <u>3 E IN 1/4 E IN</u> Street address of well location if in city: <u>muscotah</u>	
3. Owner of well: <u>IRVING Boldridge</u> R.R. or street: <u>RR.</u> City, state, zip code: <u>muscotah, Ks.</u>	
4. Locate with "X" in section below: Sketch map:  <u>well X for New home site</u>	
5. Type and color of material	
6. Bore hole dia. <u>10 1/2</u> in. Completion date <u>4-16-77</u> Well depth <u>100</u> ft.	
7. <input checked="" type="checkbox"/> Cable tool <input checked="" type="checkbox"/> Rotary <input type="checkbox"/> Driven <input type="checkbox"/> Dug <input type="checkbox"/> Hollow rod <input type="checkbox"/> Jetted <input type="checkbox"/> Bored <input type="checkbox"/> Reverse rotary	
8. Use: <input checked="" type="checkbox"/> Domestic <input type="checkbox"/> Public supply <input type="checkbox"/> Industry <input type="checkbox"/> Irrigation <input type="checkbox"/> Air conditioning <input type="checkbox"/> Stock <input type="checkbox"/> Lawn <input type="checkbox"/> Oil field water <input type="checkbox"/> Other	
9. Casing: Material <u>PVC</u> Height <u>Above</u> or below Surface <u>24</u> in. Threaded <input type="checkbox"/> Welded <input type="checkbox"/> RMP <u>PVC Blue</u> Weight <u>2.74</u> lbs./ft. Dia. <u>5</u> in. to <u>100</u> ft. depth Wall Thickness: inches or Dia. <u>5</u> in. to <u>100</u> ft. depth gage No. <u>258</u>	
10. Screen: Manufacturer's name <u>Pumpco</u> Type <u>PVC</u> Dia. <u>5"</u> Slot/gauze <u>.090</u> Length <u>15</u> ft. Set between <u>75</u> ft. and <u>90</u> ft. Gravel pack? <input checked="" type="checkbox"/> Size range of material <u>1/8 - 1/4</u>	
11. Static water level: <u>70</u> ft. below land surface Date <u>4-16-77</u> mo./day/yr.	
12. Pumping level below land surfaces: <u>Air test</u> <u>3</u> g.p.m. Estimated maximum yield <u>3</u> g.p.m.	
13. Water sample submitted: <input checked="" type="checkbox"/> Yes <input type="checkbox"/> No Date <u>4-16-77</u> mo./day/yr.	
14. Well head completion: <u>Top cap</u> Pitless adapter <u>24</u> inches above grade	
15. Well grouted? <u>Yes</u> With: <input checked="" type="checkbox"/> Neat cement <input type="checkbox"/> Bentonite <input type="checkbox"/> Concrete Depth: From <u>5</u> ft. to <u>15</u> ft.	
16. Nearest source of possible contamination: <u>*</u> ft. Direction Type Well disinfected upon completion? <input type="checkbox"/> Yes <input type="checkbox"/> No	
17. Pump: <input checked="" type="checkbox"/> Not installed Manufacturer's name Model number HP Volts Length of drop pipe ft. capacity g.p.m. Type: <input type="checkbox"/> Submersible <input type="checkbox"/> Turbine <input type="checkbox"/> Jet <input type="checkbox"/> Reciprocating <input type="checkbox"/> Centrifugal <input type="checkbox"/> Other	
(Use a second sheet if needed)	
18. Elevation: <u>1088</u> Topography: <input checked="" type="checkbox"/> Hill <input type="checkbox"/> Slope <input type="checkbox"/> Upland <input type="checkbox"/> Valley	19. Remarks: <u>owner will construct cement slab around well</u> <u>* New Home site No construction started. In wheat field.</u>
20. Water well contractor's certification: This well was drilled under my jurisdiction and this report is true to the best of my knowledge and belief. <u>STRADER DRLG Co Inc</u> License No. <u>182</u> Business name <u>RTI Holton, Ks</u> Address <u>Dale Padon</u> Signed <u>Dale Padon</u> Authorized representative Date <u>6-3-77</u>	