


1 LOCATION OF WATER WELL: Fraction W 1/2 of Section Number 13 Township Number 55 Range Number 17E  
 County: Adairson SE 1/4 1/4 1/4

Distance and direction from nearest town or city street address of well if located within city?  
10 Mile NW of Estlin, KS N/A

2 WATER WELL OWNER: James Zwornitz  
 RR#, St. Address, Box #: 10799 Chayenne Rd Board of Agriculture, Division of Water Resources  
 City, State, ZIP Code: Horton KS 66439 Application Number: 18

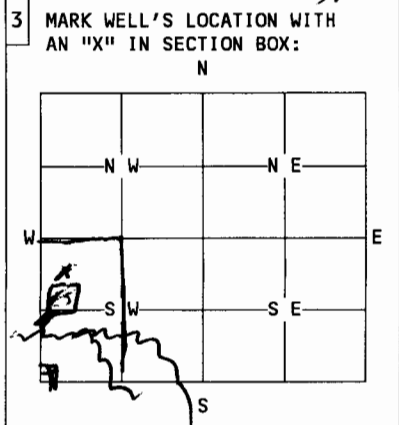

4 DEPTH OF WELL.....18.....ft.  
 WELL'S STATIC WATER LEVEL.....ft.  
 WELL WAS USED AS:  
 1 Domestic      5 Public Water Supply      9 Dewatering  
 2 Irrigation      6 Oil Field Water Supply      10 Monitoring Well  
 3 Feedlot      7 Lawn and Garden Only      11 Injection Well  
 4 Industrial      8 Air Conditioning      12 Other.....  
 Was a chemical/bacteriological sample submitted to Department? Yes.....No.....  
 If yes, mo/day/yr sample was submitted.....  
 Water Well Disinfected: Yes  No..... 3gal Chlorox Added to water

5 TYPE OF BLANK CASING USED:  
 1 Steel    3 RMP (SR)    5 Wrought    7 Fiberglass    9 Other (specify below)  
 2 PVC    4 ABS    6 Asbestos-Cement    8 Concrete Tile    Rock Wall Layed  
 Blank casing diameter.....3.....in.    Was casing pulled? Yes  No..... If yes, how much.....6 ft  
 Casing height above or below land surface.....6 ft.....in. after taking out

6 GROUT PLUG MATERIAL: 1 Neat cement    2 Cement grout    3 Bentonite    4 Other.....Sand + Clay  
 Grout Plug Intervals: From.....ft. to.....ft., From.....ft. to.....ft., From.....ft. to.....ft.  
Add 3.4 yd Sand the Clay + Bentonite Plug the Top 56" at ground level 24"  
 What is the nearest source of possible contamination:  
 1 Septic tank    6 Seepage pit    11 Fuel storage    16 Other (specify below)  
 2 Sewer lines    7 Pit privy    12 Fertilizer storage    Brown fields + Cropland in watershed above area  
 3 Watertight sewer lines    8 Sewage lagoon    13 Insecticide storage  
 4 Lateral lines    9 Feedyard    14 Abandoned water well  
 5 Cess Pool    10 Livestock pens    15 Oil well/Gas well  
 Direction from well? .....East.....    How many feet? .....14 Acres  
40 RODS.

FROM	TO	PLUGGING MATERIALS
<u>18</u>	<u>6"</u>	<u>Sand</u>
<u>6</u>	<u>3</u>	<u>Clay</u>
<u>3</u>	<u>2.0'</u>	<u>Bentonite</u>
<u>2</u>	<u>0</u>	<u>Top Soil</u>

7 CONTRACTOR'S OR LANDOWNER'S CERTIFICATION: This water well was plugged under my jurisdiction and was completed on (mo/day/year)..... and this record is true to the best of my knowledge and belief. Kansas Water Well Contractor's License No. .... This Water Well Record was completed on (mo/day/year)..... under the business name of A. B. T. & K. K. K. Contractor by (signature) James Zwornitz

INSTRUCTIONS: Use typewriter or ball point pen. Please press firmly and print clearly. Please fill in blanks, underline or circle the correct answers. Send top three copies to Kansas Department of Health and Environment, Bureau of Water, Topeka, Kansas 66620-0001. Telephone: 913/296-3565. Send one to Water Well Owner and retain one for your records.