

1 LOCATION OF WATER WELL:	Fraction	Section Number	Township Number	Range Number
County: <u>Atchison</u>	<u>NW 1/4 SE 1/4 NE 1/4</u>	<u>4</u>	<u>T 55 S</u>	<u>R 17 E</u>

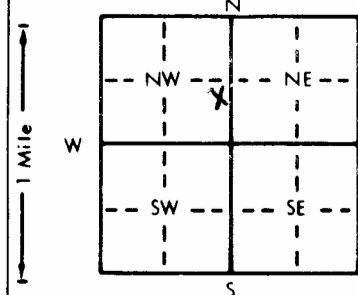
Distance and direction from nearest town or city street address of well if located within city?

1 mile South of 2 miles East of Horton KS.

2 WATER WELL OWNER:	Board of Agriculture, Division of Water Resources
RR#, St. Address, Box # :	Application Number:
City, State, ZIP Code :	

Mike RockRt 1 Horton, KS 66439

3 LOCATE WELL'S LOCATION WITH AN "X" IN SECTION BOX:	4 DEPTH OF COMPLETED WELL: <u>58'</u> ft. ELEVATION:
--	--

Depth(s) Groundwater Encountered 10' 20" ft. 2. ft. 3. ft.WELL'S STATIC WATER LEVEL 10' 20" ft. below land surface measured on mo/day/yr

Pump test data: Well water was ft. after hours pumping gpm

Est. Yield 6 1/2 gpm: Well water was ft. after hours pumping gpmBore Hole Diameter 9" in. to ft. and in. to ft.

WELL WATER TO BE USED AS:

1 Domestic3 Feedlot6 Oil field water supply8 Air conditioning11 Injection well2 Irrigation4 Industrial7 Lawn and garden only9 Dewatering12 Other (Specify below)Was a chemical/bacteriological sample submitted to Department? Yes. No. ☒ If yes, mo/day/yr sample was submitted

Water Well Disinfected? Yes No

5 TYPE OF BLANK CASING USED:	5 Wrought iron	8 Concrete tile	CASING JOINTS: Glued <input checked="" type="checkbox"/> Clamped
1 Steel	3 RMP (SR)	6 Asbestos-Cement	9 Other (specify below)
2 PVC	4 ABS	7 Fiberglass	Welded
Blank casing diameter <u>6"</u> in. to ft. Dia			Threaded

Casing height above land surface 24" in. weight lbs./ft. Wall thickness or gauge No. Sch # 40

TYPE OF SCREEN OR PERFORATION MATERIAL:

1 Steel	3 Stainless steel	5 Fiberglass	8 RMP (SR)	10 Asbestos-cement
2 Brass	4 Galvanized steel	6 Concrete tile	9 ABS	11 Other (specify)
				12 None used (open hole)

SCREEN OR PERFORATION OPENINGS ARE:

1 Continuous slot	3 Mill slot	5 Gauzed wrapped	6 Saw cut	11 None (open hole)
2 Louvered shutter	4 Key punched	6 Wire wrapped	9 Drilled holes	
		7 Torch cut	10 Other (specify)	

SCREEN-PERFORATED INTERVALS: From 20' ft. to 50' ft. From ft. to ft.

From ft. to ft. From ft. to ft.

GRAVEL PACK INTERVALS: From 19' ft. to 58' ft. From ft. to ft.

From ft. to ft. From ft. to ft.

6 GROUT MATERIAL:	1 Neat cement	2 Cement grout	3 <u>Bentonite</u>	4 Other
Grout intervals: From <u>0</u> ft. to <u>19'</u> ft. From ft. to ft. From ft. to ft.				

What is the nearest source of possible contamination:

1 Septic tank	4 Lateral lines	7 Pit privy	10 Livestock pens	14 Abandoned water well
2 Sewer lines	5 Cess pool	8 Sewage lagoon	11 Fuel storage	15 Oil well/Gas well
3 Watertight sewer lines	6 Seepage pit	9 Feedyard	12 Fertilizer storage	16 Other (specify below)
			13 Insecticide storage	<u>none</u>

Direction from well?

How many feet?

FROM	TO	LITHOLOGIC LOG	FROM	TO	PLUGGING INTERVALS
<u>0</u>	<u>3</u>	<u>TOP SOIL</u>			
<u>3</u>	<u>20</u>	<u>Brown SANDY clay</u>			
<u>20</u>	<u>23</u>	<u>Lime stone</u>			
<u>23</u>	<u>58</u>	<u>gray clay</u>			

7 CONTRACTOR'S OR LANDOWNER'S CERTIFICATION: This water well was (1) <u>constructed</u> , (2) reconstructed, or (3) plugged under my jurisdiction and was completed on (mo/day/year) <u>5-23-93</u> and this record is true to the best of my knowledge and belief. Kansas
Water Well Contractor's License No. <u>526</u> This Water Well Record was completed on (mo/day/yr) <u>6-14-93</u>
under the business name of <u>Well Drilling</u> by (signature) <u>Fred Mott</u>

INSTRUCTIONS: Use typewriter or ball point pen. PLEASE PRESS FIRMLY and PRINT clearly. Please fill in blanks, underline or circle the correct answers. Send top three copies to Kansas Department of Health and Environment, Bureau of Water, Topeka, Kansas 66620-7320. Telephone: 913-296-5545. Send one to WATER WELL OWNER and retain one for your records.