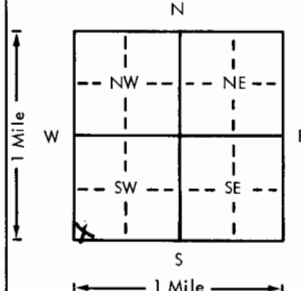
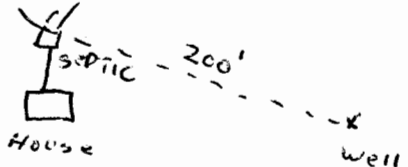


USE TYPEWRITER OR BALL
POINT PEN. PRESS FIRMLY.
PRINT CLEARLY.

WATER WELL RECORD
KSA 82a-1201-1215

PSD

Kansas Department of Health and
Environment-Division of Environment
(Water well Contractors)
Topeka, Kansas 66620

1. Location of well:		County <u>Holmes</u>	Fraction <u>SE 1/4 SW 1/4</u>	Section number <u>7</u>	Township number <u>5</u>	Range number <u>18</u>
2. Distance and direction from nearest town or city: <u>3 S - 4 E</u>		3. Owner of well: <u>O.W. DAHL</u>				
Street address of well location if in city: <u>OF HORTON</u>		City, state, zip code: <u>HORTON KS</u>				
4. Locate with "X" in section below:		Sketch map:		6. Bore hole dia. <u>10</u> in. Completion date <u>3-1-77</u>		
				7. Cable tool <input checked="" type="checkbox"/> Rotary <input type="checkbox"/> Driven <input type="checkbox"/> Dug <input type="checkbox"/> Hollow rod <input type="checkbox"/> Jetted <input type="checkbox"/> Bored <input type="checkbox"/> Reverse rotary		
5. Type and color of material		From		To		8. Use: <input checked="" type="checkbox"/> Domestic <input type="checkbox"/> Public supply <input type="checkbox"/> Industry <input type="checkbox"/> Irrigation <input type="checkbox"/> Air conditioning <input type="checkbox"/> Stock <input type="checkbox"/> Lawn <input type="checkbox"/> Oil field water <input type="checkbox"/> Other
Top soil		0		5		9. Casing: Material <u>PVC</u> Height: <u>Above</u> or below
Clay, yellow		5		65		Threaded <input type="checkbox"/> Welded <input type="checkbox"/> Surface <u>29</u> in.
Fine sand		65		95		RMP <u>PVC</u> <u>4L</u> Weight <u>2.58</u> lbs./ft.
Clay, Blue		95		99		Dia. <u>5</u> in. to <u>120</u> ft. depth Wall Thickness: inches or
Coarse sand - Peagravel		99		113		Dia. <u>5</u> in. to <u>120</u> ft. depth gauge No. <u>2-77</u>
Shale, grey		113		120		10. Screen: Manufacturer's name <u>Pumpco</u>
						Type <u>PVC</u> Dia. <u>5</u>
						<input checked="" type="checkbox"/> gauze <u>100</u> Length <u>20</u>
						Set between <u>100</u> ft. and <u>120</u> ft.
						Gravel pack? <input checked="" type="checkbox"/> Size range of material <u>20-30 x 60</u>
						11. Static water level: <u>80</u> ft. below land surface Date <u>3-1-77</u>
						12. Pumping level below land surfaces: <u>Air test</u>
						<u>20</u> ft. after <u>20</u> hrs. pumping <u>20</u> g.p.m.
						Estimated maximum yield <u>20</u> g.p.m.
						13. Water sample submitted: <u>Yes</u> <input checked="" type="checkbox"/> No <input type="checkbox"/> Date <u>3-1-77</u>
						14. Well head completion: <u>CAP</u>
						<u>24</u> Pitless adapter <u>24</u> inches above grade
						15. Well grouted? <input checked="" type="checkbox"/>
						With: <input checked="" type="checkbox"/> Neat cement <input type="checkbox"/> Bentonite <input type="checkbox"/> Concrete
						Depth: From <u>5</u> ft. to <u>15</u> ft.
						16. Nearest source of possible contamination: <u>septic</u>
						ft. <u>200</u> Direction <u>W</u> Type <u>septic</u>
						Well disinfected upon completion? <input checked="" type="checkbox"/> Yes <input type="checkbox"/> No
						17. Pump: <input checked="" type="checkbox"/> Not installed
						Manufacturer's name <u>Strader Drilling Co.</u>
						Model number <u>182</u> HP <u>1</u> Volts <u>115</u>
						Length of drop pipe <u>1</u> ft. capacity <u>1</u> g.p.m.
						Type: <input type="checkbox"/> Submersible <input type="checkbox"/> Turbine <input type="checkbox"/> Jet <input type="checkbox"/> Reciprocating <input type="checkbox"/> Centrifugal <input type="checkbox"/> Other
18. Elevation:		19. Remarks:		20. Water well contractor's certification:		
Topography: <input checked="" type="checkbox"/> Hill <input type="checkbox"/> Slope <input type="checkbox"/> Upland <input type="checkbox"/> Valley		<u>OWNER WILL INSTALL SLAB</u>		This well was drilled under my jurisdiction and this report is true to the best of my knowledge and belief.		
				Business name <u>Strader Drilling Co.</u> License No. <u>182</u>		
				Address <u>RR #1 Horton, KS</u>		
				Signed <u>Gary Johnson</u> Date <u>3-3-77</u>		
				Authorized representative		