


LOCATION OF WATER WELL: County: **Atchinson** Fraction: **SW 1/4 of NW 1/4** Section Number: **17** Township Number: **T 5 S** Range Number: **R 18 E/W**

Distance and direction from nearest town or city street address of well if located within city?

2 WATER WELL OWNER: **Arensberg Farms Inc** **Lee Arensberg**
 RR#, St. Address, Box #: **613 Commercial** Board of Agriculture, Division of Water Resources
 City, State, ZIP Code: **Atchinson Ks 66002** Application Number:

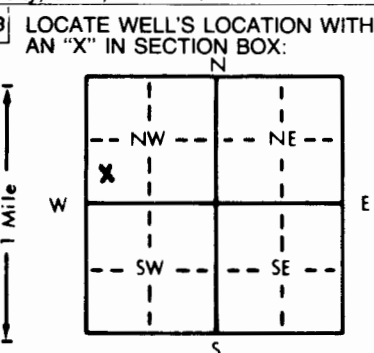

4 DEPTH OF COMPLETED WELL: **53** ft. ELEVATION:
 Depth(s) Groundwater Encountered 1. **51** ft. 2. ft. 3. ft.
 WELL'S STATIC WATER LEVEL **51** ft. below land surface measured on mo/day/yr **3/9/91**
 Pump test data: Well water was ft. after hours pumping gpm
 Est. Yield gpm: Well water was ft. after hours pumping gpm
 Bore Hole Diameter in. to ft., and in. to ft.
 WELL WATER TO BE USED AS:
 1 Domestic 3 Feedlot 6 Oil field water supply 9 Dewatering 11 Injection well
 2 Irrigation 4 Industrial 7 Lawn and garden only 10 Monitoring well
 Was a chemical/bacteriological sample submitted to Department? Yes No; If yes, mo/day/yr sample was submitted
 Water Well Disinfected? Yes No

5 TYPE OF BLANK CASING USED:
 1 Steel 3 RMP (SR) 5 Wrought iron 8 Concrete tile CASING JOINTS: Glued Clamped
 2 PVC 4 ABS 6 Asbestos-Cement 9 Other (specify below) Welded
 7 Fiberglass **Brick** Threaded
 Blank casing diameter **4 ft** x to **4** ft., Dia **3 ft** x to **53** ft., Dia in. to ft.
 Casing height above land surface in., weight lbs./ft. Wall thickness or gauge No.
 TYPE OF SCREEN OR PERFORATION MATERIAL:
 1 Steel 3 Stainless steel 5 Fiberglass 8 RMP (SR) 10 Asbestos-cement 11 Other (specify)
 2 Brass 4 Galvanized steel 6 Concrete tile 9 ABS 12 None used (open hole)
 SCREEN OR PERFORATION OPENINGS ARE:
 1 Continuous slot 3 Mill slot 5 Gauzed wrapped 8 Saw cut 11 None (open hole)
 2 Louvered shutter 4 Key punched 6 Wire wrapped 9 Drilled holes
 7 Torch cut 10 Other (specify)
 SCREEN-PERFORATED INTERVALS: From ft. to ft., From ft. to ft., From ft. to ft.
 GRAVEL PACK INTERVALS: From ft. to ft., From ft. to ft., From ft. to ft.

6 GROUT MATERIAL: 1 Neat cement 2 Cement grout 3 Bentonite 4 Other
 Grout Intervals: From ft. to ft., From ft. to ft., From ft. to ft.
 What is the nearest source of possible contamination:
 1 Septic tank 4 Lateral lines 7 Pit privy 10 Livestock pens 14 Abandoned water well
 2 Sewer lines 5 Cess pool 8 Sewage lagoon 11 Fuel storage 15 Oil well/Gas well
 3 Watertight sewer lines 6 Seepage pit 9 Feedyard 12 Fertilizer storage 16 Other (specify below)
FIELD FARMING
 Direction from well? How many feet? **1W FIELD**

FROM	TO	LITHOLOGIC LOG	FROM	TO	PLUGGING INTERVALS
			53	51	Chlorinated SAND
			51	4 1/2	Subsoil
			4 1/2	3 1/2	Bentonite Clay
			3 1/2	0	Soil

7 CONTRACTOR'S OR LANDOWNER'S CERTIFICATION: This water well was (1) constructed, (2) reconstructed, or (3) plugged under my jurisdiction and was completed on (mo/day/year) **3/9/91** and this record is true to the best of my knowledge and belief. Kansas Water Well Contractor's License No. This Water Well Record was completed on (mo/day/yr) **3/9/91** under the business name of by (signature) **Danny H. Rogers**