

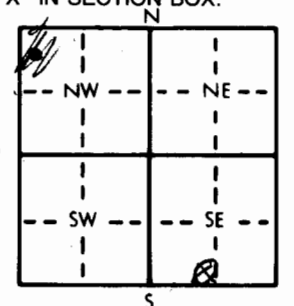
62 Addison W.

VJD

1 LOCATION OF WATER WELL: Fraction ~~SW 1/4 NW 1/4 NW 1/4~~ Section Number 57 Township Number T 5 S R 20 E/W 19

Distance and direction from nearest town or city street address of well if located within city?
4 mi W 3/4 N ATCHISON 36

2 WATER WELL OWNER: DRIMMEL FARMS
 RR#, St. Address, Box #: RR4
 City, State, ZIP Code: ATCHISON KANSAS 66002
 Board of Agriculture, Division of Water Resources
 Application Number:

3 LOCATE WELL'S LOCATION WITH AN "X" IN SECTION BOX:


4 DEPTH OF COMPLETED WELL: 95 ft. ELEVATION: 1105 RM
 Depth(s) Groundwater Encountered 1. 75 ft. 2. ft. 3. ft.
 WELL'S STATIC WATER LEVEL 55 ft. below land surface measured on mo/day/yr 12-7-81
 Pump test data: Well water was ft. after hours pumping gpm
 Est. Yield 8 gpm: Well water was ft. after hours pumping gpm
 Bore Hole Diameter: 10 in. to 20 ft., and 8 in. to 75 ft.
 WELL WATER TO BE USED AS:
 1 Domestic 3 Feedlot 6 Oil field water supply 9 Dewatering 12 Other (Specify below)
 2 Irrigation 4 Industrial 7 Lawn and garden only 10 Observation well
 Was a chemical/bacteriological sample submitted to Department? Yes No ; If yes, mo/day/yr sample was submitted
 Water Well Disinfected? Yes No

5 TYPE OF BLANK CASING USED:
 1 Steel 3 RMP (SR) 5 Wrought iron 8 Concrete tile CASING JOINTS: Glued Clamped
 2 PVC 4 ABS 6 Asbestos-Cement 9 Other (specify below) Welded
 7 Fiberglass Threaded
 Blank casing diameter 6 in. to 95 ft., Dia. in. to ft., Dia. in. to ft.
 Casing height above land surface: 18 in., weight lbs./ft. Wall thickness or gauge No. 332
 TYPE OF SCREEN OR PERFORATION MATERIAL:
 1 Steel 3 Stainless steel 5 Fiberglass 8 RMP (SR) 10 Asbestos-cement 11 Other (specify)
 2 Brass 4 Galvanized steel 6 Concrete tile 9 ABS 12 None used (open hole)
 SCREEN OR PERFORATION OPENINGS ARE:
 1 Continuous slot 3 Mill slot 5 Gauzed wrapped 8 Saw cut 11 None (open hole)
 2 Louvered shutter 4 Key punched 6 Wire wrapped 9 Drilled holes
 7 Torch cut 10 Other (specify)
 SCREEN-PERFORATED INTERVALS: From 70 ft. to 90 ft., From ft. to ft.
 GRAVEL PACK INTERVALS: From 20 ft. to 95 ft., From ft. to ft.

6 GROUT MATERIAL: 1 Neat cement 2 Cement grout 3 Bentonite 4 Other
 Grout Intervals: From 4 ft. to 20 ft., From ft. to ft., From ft. to ft.
 What is the nearest source of possible contamination:
 1 Septic tank 4 Lateral lines 7 Pit privy 10 Livestock pens 14 Abandoned water well
 2 Sewer lines 5 Cess pool 8 Sewage lagoon 11 Fuel storage 15 Oil well/Gas well
 3 Watertight sewer lines 6 Seepage pit 9 Feedyard 12 Fertilizer storage 16 Other (specify below)
 13 Insecticide storage
 Direction from well? NORTH How many feet? 250

FROM	TO	LITHOLOGIC LOG	FROM	TO	LITHOLOGIC LOG
0	1	TOP SOIL			
1	15	SUGAR LOAM			
15	53	SANDY BROWN CLAY			
53	56	HARD IRON DEPOSITS			
56	71	MEALY SAND			
71	83	GRAVELY SAND			
83	85	GRAY SHALE			
85	93	BLUE SHALE			
93	95	LIMESTONE			

7 CONTRACTOR'S OR LANDOWNER'S CERTIFICATION: This water well was (1) constructed, (2) reconstructed, or (3) plugged under my jurisdiction and was completed on (mo/day/year) Dec. 7, 1981 and this record is true to the best of my knowledge and belief. Kansas Water Well Contractor's License No. 317 This Water Well Record was completed on (mo/day/yr) 1-3-82
 under the business name of WILLIAMSON Well DRIG. by (signature) Thomas Kramer

INSTRUCTIONS: Use typewriter or ball point pen, PLEASE PRESS FIRMLY and PRINT clearly. Please fill in blanks, underline or circle the correct answers. Send top three copies to Kansas Department of Health and Environment, Division of Environment, Environmental Geology Section, Topeka, KS 66620. Send one to WATER WELL

OFFICE USE ONLY