

NOTE: Figures exhibited within this report are only to be used within the context of this report. Placement of property lines, wells, structures, and roads is based on the available information from county appraiser maps, surveys, site visits, and/or previous vendor reports and should be considered approximate.

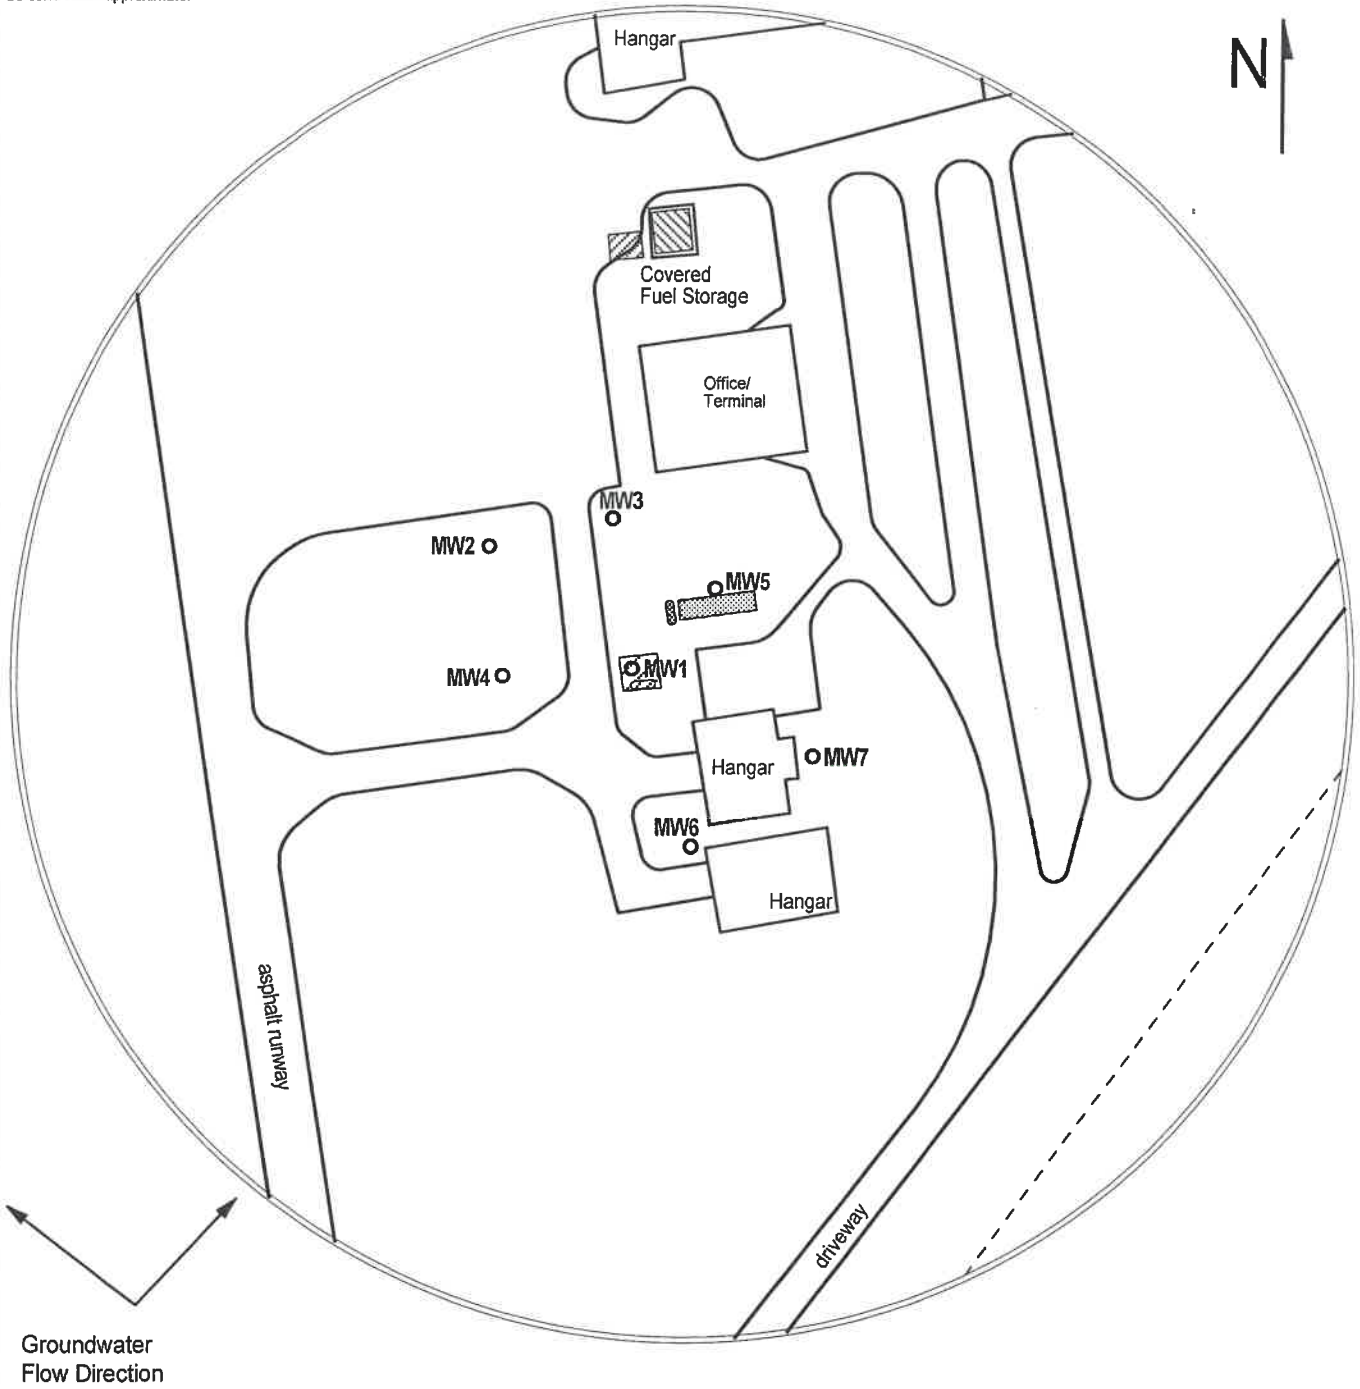







FIGURE 1 - 350 FT SITE BASE MAP

LEGEND:

-  Approximate Location of Former UST Basins
-  Approximate Location of Active UST Basin
-  Approximate Location of Active Jet Fuel AST & Pump
-  Approximate Location of Property Line
-  Plugged Monitoring Well



PROJECT:
 Amelia Earhart Airport
 Route #3
 Atchison, KS
 KDHE ID: U4-003-11175
 Date: 8/4/22



1311 E 25th St., Suite B (785) 841-8707 office
 Lawrence, KS 66046 (785) 865-4282 fax

NOTE: Location of active and former product lines is unknown.