


1 LOCATION OF WATER WELL: Fraction 3/4 S 1/4 SE 1/4 Section Number 30 Township Number T 5 S Range Number R 20E E/W

County: ATCHISON Distance and direction from nearest town or city street address of well if located within city? 3 3/4 west of Atchison

2 WATER WELL OWNER: Atchison Co. Solid Waste RR#, St. Address, Box #: Atchison Co. Courthouse City, State, ZIP Code: Atchison, KS 66002 Board of Agriculture, Division of Water Resources Application Number:

3 LOCATE WELL'S LOCATION WITH AN "X" IN SECTION BOX: 4 DEPTH OF COMPLETED WELL: 20 ft. ELEVATION: none ft. below land surface measured on mo/day/yr 3-03-95

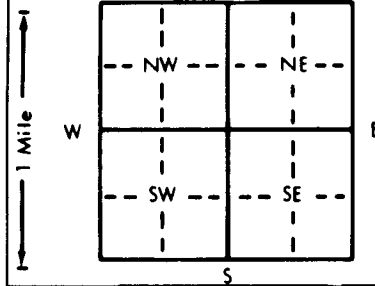

Depth(s) Groundwater Encountered 1... ft. 2... ft. 3... ft. WELL'S STATIC WATER LEVEL... Pump test data: Well water was... Est. Yield... Bore Hole Diameter... WELL WATER TO BE USED AS: 5 Public water supply 8 Air conditioning 11 Injection well 1 Domestic 3 Feedlot 6 Oil field water supply 9 Dewatering 12 Other (Specify below) 2 Irrigation 4 Industrial 7 Lawn and garden only 10 Monitoring well Was a chemical/bacteriological sample submitted to Department? Yes... No X...; If yes, mo/day/yr sample was submitted Water Well Disinfected? Yes No X

5 TYPE OF BLANK CASING USED: 1 Steel * 3 RMP (SR) 5 Wrought iron 8 Concrete tile CASING JOINTS: Glued Clamped 2 PVC 4 ABS 6 Asbestos-Cement 9 Other (specify below) Welded 7 Fiberglass Threaded flush jt.

Blank casing diameter 4 in. to 20 ft. Dia 2 in. to ft. Dia 2 in. to ft. Casing height above land surface 24 in. weight 2.04 lbs./ft. Wall thickness or gauge No. 237

TYPE OF SCREEN OR PERFORATION MATERIAL: 1 Steel 3 Stainless steel 5 Fiberglass 7 PVC 10 Asbestos-cement 2 Brass 4 Galvanized steel 6 Concrete tile 8 RMP (SR) 11 Other (specify) 12 None used (open hole)

SCREEN OR PERFORATION OPENINGS ARE: 1 Continuous slot 3 Mill slot 5 Gauzed wrapped 8 Saw cut 11 None (open hole) 2 Louvered shutter 4 Key punched 6 Wire wrapped 9 Drilled holes 7 Torch cut 10 Other (specify)

SCREEN-PERFORATED INTERVALS: From 10 ft. to 20 ft. From ft. to ft. From ft. to ft. GRAVEL PACK INTERVALS: From 7 ft. to 20 ft. From ft. to ft. From ft. to ft.

6 GROUT MATERIAL: 1 Neat cement 2 Cement grout 3 Bentonite 4 Other Grout intervals: From 0 ft. to 7 ft. From ft. to ft. From ft. to ft.

What is the nearest source of possible contamination: 1 Septic tank 4 Lateral lines 7 Pit privy 10 Livestock pens 14 Abandoned water well 2 Sewer lines 5 Cess pool 8 Sewage lagoon 11 Fuel storage 15 Oil well/Gas well 3 Watertight sewer lines 6 Seepage pit 9 Feedyard 12 Fertilizer storage 16 Other (specify below) 13 Insecticide storage

Direction from well? south How many feet? 200'

Table with columns: FROM, TO, LITHOLOGIC LOG, FROM, TO, PLUGGING INTERVALS. Rows: 0-11 Brown Clay, 11-13 Grey Shale, 13-15 Grey Limestone, 15-18 Grey Shale, 18-20 Grey Shaley Limestone. Includes note: * 8" steel cover with locking cap on top 3' above ground.

7 CONTRACTOR'S OR LANDOWNER'S CERTIFICATION: This water well was (1) constructed, (2) reconstructed, or (3) plugged under my jurisdiction and was completed on (mo/day/year) 3-03-95 and this record is true to the best of my knowledge and belief. Kansas Water Well Contractor's License No. 182 This Water Well Record was completed on (mo/day/yr) 3-23-95 under the business name of STRADER DRILLING CO., INC. by (signature) Dale Skren