

USE TYPEWRITER OR BALL POINT PEN—PRESS FIRMLY, PRINT CLEARLY.


WATER WELL RECORD
KSA 82a-1201-1215

Kansas Department of Health and Environment—Division of Environment
(Water well Contractors)
Topeka, Kansas 66620

BBC 5 5

1. Location of well: County Doniphan Fraction NW Section number 000 Township number T 8 S Range number 21
SW 1/4 1/4 NE 1/4 1/4 W 1/4 1/4 E

2. Distance and direction from nearest town or city: 9 mi. S. Troy 3. Owner of well: Larry Sandy
Street address of well location if in city: R.R. or street: RR #2
City, state, zip code: Atchison, KS 66002

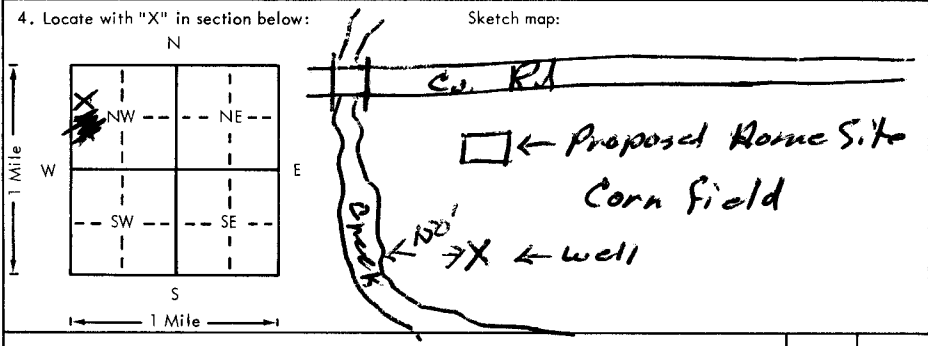

6. Bore hole dia. 10 in. Completion date _____
Well depth 100 ft. 6-14-79

7. Cable tool Rotary Driven Dug
 Hollow rod Jetted Bored Reverse rotary

8. Use: Domestic Public supply Industry
 Irrigation Air conditioning Stock
 Lawn Oil field water Other

9. Casing: Material PVC Height: Above or below
Threaded Welded Surface 24 in.
RMP _____ PVC Blue Weight 2.74 lbs./ft.
Dia. 5 in. to 40 ft. depth Wall Thickness: inches or
Dia. _____ in. to _____ ft. depth gage No. 258

5. Type and color of material	From	To
Top Soil	0	4
Black loam	4	8
Blue Silty Clay	8	23
Blue Med. Sand	23	34
Black Clay	34	38
Blue Silt	38	70
Blue Coarse Sand	70	72
Coarse Creek Gravel (cherty)	72	76
Black & Gray Shale	76	100

10. Screen: Manufacturer's name Pump Co MPI
Type PVC Dia. 5
Slot/gauge 020 Length 10
Set between 70 ft. and 80 ft.
Gravel pack? Size range of material 10/20/30

11. Static water level: _____ mo./day/yr.
20 ft. below land surface Date 6-14-79

12. Pumping level below land surfaces: Air Test
_____ ft. after _____ hrs. pumping _____ g.p.m.
_____ ft. after _____ hrs. pumping _____ g.p.m.
Estimated maximum yield 12 g.p.m.

13. Water sample submitted: _____ mo./day/yr.
Yes No Date _____

14. Well head completion: Top Cap
Pitless adapter 24 inches above grade

15. Well grouted?
With: Neat cement Bentonite Concrete
Depth: From 5 ft. to 15 ft.

16. Nearest source of possible contamination:
ft. 150 Direction W Type Creek
Well disinfected upon completion? Yes No

17. Pump: Not installed
Manufacturer's name _____
Model number _____ HP _____ Volts _____
Length of drop pipe _____ ft. capacity _____ g.p.m.
Type: _____
 Submersible Turbine
 Jet Reciprocating
 Centrifugal Other

18. Elevation: 859 Rm
Topography: Hill Slope Upland Valley

19. Remarks: owner to install slab

20. Water well contractor's certification:
This well was drilled under my jurisdiction and this report is true to the best of my knowledge and belief.
Strader Drig Co. Inc 182
Business name License No.
Address RT1 Holton, KS
Signed Dale Astern Date 6-14-79
Authorized representative

T 4
R 0210
W 33
Sec NW SW
1/4 1/4 1/4