

CORRECTION(S) TO WATER WELL RECORD (WWC-5)

(to rectify lacking or incorrect information)

County: Atchison

Location listed as:

Location changed to:

Section-Township-Range: 18-05-21E

18-55-21E

Fraction ($\frac{1}{4}$ $\frac{1}{4}$ $\frac{1}{4}$): None Given

NE NW NW

Other changes: Initial statements: _____

Changed to: _____

Comments: _____

verification method: Legal description, county ownership map, and aerial photos on KGS website.


initials: DRJ date: 7/16/2005

submitted by: Kansas Geological Survey, Data Resources Library, 1930 Constant Ave., Lawrence, KS 66047-3726
to: Kansas Dept of Health & Environment, Bureau of Water, 1000 SW Jackson, Suite 420, Topeka, KS 66612-1367.

1 LOCATION OF WATER WELL: Fraction Section Number Township Number Range Number
 County: **ATCHISON** $\frac{1}{4}$ $\frac{1}{4}$ $\frac{1}{4}$ **18** **05** **21E**_{E/W}

Distance and direction from nearest town or city street address of well if located within city?

2 WATER WELL OWNER: **EDWIN AMREIN**
 RR #, St. Address, Box #: **124 E MOUND ST** Board of Agriculture, Division of Water Resources
 City, State, ZIP Code: **ATCHISON, KANSAS 66002** Application Number:

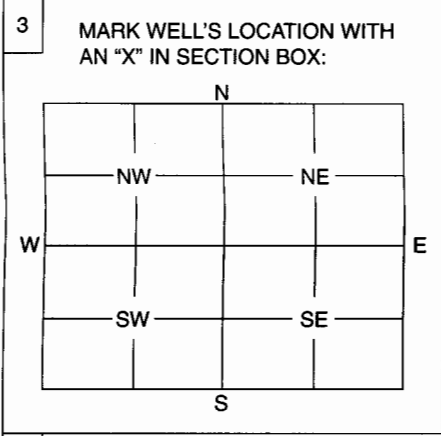

4 DEPTH OF WELL **38** ft.
 WELL'S STATIC WATER LEVEL **24'** ft.
 WELL WAS USED AS:
 1 Domestic 5 Public Water Supply 9 Dewatering
 2 Irrigation 6 Oil Field Water Supply 10 Monitoring Well
 3 Feedlot 7 Domestic (Lawn & Garden) 11 Injection Well
 4 Industrial 8 Air Conditioning 12 Other
 Was a chemical / bacteriological sample submitted to Department? Yes No
 If yes, mo/day/yr sample was submitted
 Water Well Disinfected: Yes No

5 TYPE OF BLANK CASING USED:
 1 Steel 3 RMP (SR) 5 Wrought 7 Fiberglass 9 Other (Specify below) **Brick**
 2 PVC 4 ABS 6 Asbestos-Cement 8 Concrete Tile
 Blank casing diameter **36** in. Was casing pulled? Yes No If yes, how much **5'**
 Casing height above or below land surface **1.5 ft** in.

6 GROUT PLUG MATERIAL: 1 Neat cement 2 Cement grout 3 Bentonite 4 Other
 Grout Plug Intervals: From **6** ft. to **5 1/2** ft., From ft. to ft., From to ft.
 What is the nearest source of possible contamination:
 1 Septic tank 6 Seepage pit 11 Fuel storage 16 Other (specify below) **None**
 2 Sewer lines 7 Pit privy 12 Fertilizer storage
 3 Watertight sewer lines 8 Sewage lagoon 13 Insecticide storage
 4 Lateral lines 9 Feedyard 14 Abandoned water well
 5 Cess pool 10 Livestock pens 15 Oil well/Gas well
 Direction from well? How many feet?

FROM	TO	PLUGGING MATERIALS
38	24	Sand & Chlorine
24	24	Subsoil
36	5 1/2	Bentonite
5 1/2	0	Top soil

7 CONTRACTOR'S OR LANDOWNER'S CERTIFICATION: This water well was plugged under my jurisdiction and was completed on (mo/day/year) **9-1-05** and this record is true to the best of my knowledge and belief. Kansas Water Well Contractor's License No. **9-1-05** This Water Well Record was completed on (mo/day/year) under the business name of **Falk & Sons Inc.**
 by (signature) **R. Falk**

INSTRUCTIONS: Use a pen or ballpoint pen. Please use fresh ink. Do not use a pencil. Please fill in the blank spaces with the appropriate information.