

**CORRECTION(S) TO WATER WELL RECORD (WWC-5)**

(to rectify lacking or incorrect information)

County: Atchison

**Location listed as:**

Section-Township-Range: None Given

Fraction (  $\frac{1}{4}$   $\frac{1}{4}$   $\frac{1}{4}$  ): \_\_\_\_\_

**Location changed to:**

17-5S-21E

SE SE SE

**Other changes:** Initial statements: \_\_\_\_\_

Changed to: \_\_\_\_\_

Comments: \_\_\_\_\_

verification method: Latitude & Longitude, and Atchison East

1:24,000 topo. map.

initials: DRL date: 11/29/2005


submitted by: Kansas Geological Survey, Data Resources Library, 1930 Constant Ave., Lawrence, KS 66047-3726

to: Kansas Dept of Health & Environment, Bureau of Water, 1000 SW Jackson, Suite 420, Topeka, KS 66612-1367.

1 LOCATION OF WATER WELL: Fraction  $\frac{1}{4}$   $\frac{1}{4}$   $\frac{1}{4}$  Section Number Township Number Range Number  
 County: Adairson T S R E/W

Distance and direction from nearest town or city street address of well if located within city?  
Lat- 39° 36' 36.9" Long. 95° 04' 45.6"

2 WATER WELL OWNER: Ralph Lanzrath  
 RR#, St. Address, Box #: #4 Flanigan Court Board of Agriculture, Division of Water Resources  
 City, State, ZIP Code: Augusta, KS 67010 Application Number:

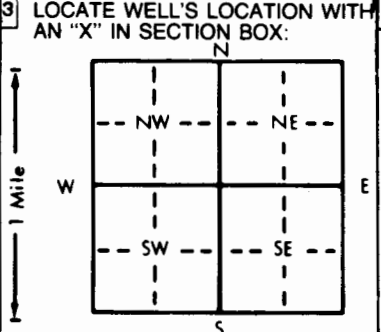

4 DEPTH OF COMPLETED WELL: 93 ft. ELEVATION:  
 Depth(s) Groundwater Encountered 1. 11 ft. 2. ft. 3. ft.  
 WELL'S STATIC WATER LEVEL 11'5" ft. below land surface measured on mo/day/yr 11-4-05  
 Pump test data: Well water was 52 ft. after 2 1/2 hours pumping 750 gpm  
 Est. Yield 2000 gpm: Well water was ft. after hours pumping gpm  
 Bore Hole Diameter: 26 in. to 93 ft., and in. to ft.  
 WELL WATER TO BE USED AS: 5 Public water supply 8 Air conditioning 11 Injection well  
 1 Domestic 3 Feedlot 6 Oil field water supply 9 Dewatering 12 Other (Specify below)  
2 Irrigation 4 Industrial 7 Lawn and garden only 10 Monitoring well  
 Was a chemical/bacteriological sample submitted to Department? Yes No X If yes, mo/day/yr sample was submitted  
 Water Well Disinfected? Yes No

5 TYPE OF BLANK CASING USED:  
 1 Steel 3 RMP (SR) 5 Wrought iron 8 Concrete tile CASING JOINTS: Glued X Clamped  
2 PVC 4 ABS 6 Asbestos-Cement 9 Other (specify below) Welded  
 7 Fiberglass Threaded  
 Blank casing diameter 16 in. to 74.5 ft., Dia in. to ft., Dia in. to ft.  
 Casing height above land surface 18 in., weight lbs./ft. Wall thickness or gauge No. 1/2" wall  
 TYPE OF SCREEN OR PERFORATION MATERIAL:  
 1 Steel 3 Stainless steel 5 Fiberglass 7 PVC 10 Asbestos-cement  
 2 Brass 4 Galvanized steel 6 Concrete tile 9 ABS 11 Other (specify)  
 12 None used (open hole)  
 SCREEN OR PERFORATION OPENINGS ARE:  
1 Continuous slot 3 Mill slot 5 Gauzed wrapped 8 Saw cut 11 None (open hole)  
 2 Louvered shutter 4 Key punched 6 Wire wrapped 9 Drilled holes  
 7 Torch cut 10 Other (specify)  
 SCREEN-PERFORATED INTERVALS: From 73 ft. to 93 ft. From ft. to ft.  
 From ft. to ft. From ft. to ft.  
 GRAVEL PACK INTERVALS: From 23 ft. to 93 ft. From ft. to ft.  
 From ft. to ft. From ft. to ft.

6 GROUT MATERIAL: 1 Neat cement 2 Cement grout 3 Bentonite 4 Other 20% solid bentonite grout (pumped)  
 Grout Intervals: From 3 ft. to 23 ft., From ft. to ft., From ft. to ft.  
 What is the nearest source of possible contamination:  
 1 Septic tank 4 Lateral lines 7 Pit privy 10 Livestock pens 14 Abandoned water well  
 2 Sewer lines 5 Cess pool 8 Sewage lagoon 11 Fuel storage 15 Oil well/Gas well  
 3 Watertight sewer lines 6 Seepage pit 9 Feedyard 12 Fertilizer storage 16 Other (specify below)  
None  
 Direction from well? How many feet?

FROM	TO	LITHOLOGIC LOG	FROM	TO	PLUGGING INTERVALS
0	5	No sample			
5	18	sand-brn VF-F			
18	45	sand-gray VF-gravel			
45	51	sand-clay-gray			
51	60	sand-gray VF-F			
60	65	sand-gravel-gray			
65	79	sand-gravel-bedded gray			
79	83	sand-gray F-gravel			
83	93	sand-gravel-gray			

7 CONTRACTOR'S OR LANDOWNER'S CERTIFICATION: This water well was (1) constructed, (2) reconstructed, or (3) plugged under my jurisdiction and was completed on (mo/day/year) 11-4-05 and this record is true to the best of my knowledge and belief. Kansas Water Well Contractor's License No. 308 This Water Well Record was completed on (mo/day/yr) 11-6-05 under the business name of Rieschick Drilling Company by (signature) Ry R...

OFFICE USE ONLY  
T  
R  
E/W  
SEC.