WATER WELL RECORD Form WWC-5 KSA 82a-1212 ID No. _____

1 LOCATION OF WATER WELL:	Fraction	Section Number	Township Number	Range Number
County: WASHINGTON	SW ¼ NE ¼ NW ¼	32	T 5 S	R 3 (E) W

Distance and direction from nearest town or city street address of well if located within city?
FROM PALMER: 3/4 MILE EAST AND 3.5 MILE SOUTH

2 WATER WELL OWNER: DICK BORRGER
RR#, St. Address, Box # : 11709 PAWNEE LANE
City, State, ZIP Code : LEAWOOD, KS 66211

Board of Agriculture, Division of Water Resources
Application Number: —

3 LOCATE WELL'S LOCATION WITH AN "X" IN SECTION BOX:

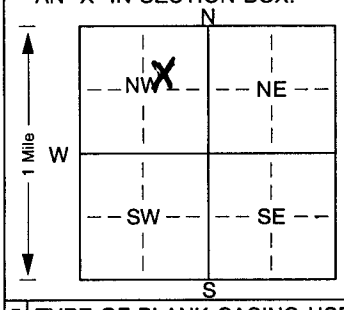

4 DEPTH OF COMPLETED WELL: 105 ft. ELEVATION: —
Depth(s) Groundwater Encountered 1. 21 ft. 2. — ft. 3. — ft.
WELL'S STATIC WATER LEVEL 17 ft. below land surface measured on mo/day/yr 5/25/00
Pump test data: Well water was — ft. after — hours pumping — gpm
Est. Yield 4 gpm: Well water was — ft. after — hours pumping — gpm
Bore Hole Diameter 8.75 in. to 105 ft., and — in. to — ft.
WELL WATER TO BE USED AS: 5 Public water supply 8 Air conditioning 11 Injection well
1 Domestic 3 Feedlot 6 Oil field water supply 9 Dewatering 12 Other (Specify below)
2 Irrigation 4 Industrial (7 Domestic (lawn & garden)) 10 Monitoring well
Was a chemical/bacteriological sample submitted to Department? Yes ____ No X ; If yes, mo/day/yrs sample was submitted
Water Well Disinfected? Yes X No

5 TYPE OF BLANK CASING USED: 5 Wrought iron 8 Concrete tile CASING JOINTS: Glued X Clamped
1 Steel 3 RMP (SR) 6 Asbestos-Cement 9 Other (specify below) Welded
(2 PVC) 4 ABS 7 Fiberglass Threaded
Blank casing diameter 5 in. to 85 ft., Dia — in. to — ft., Dia — in. to — ft.
Casing height above land surface 18 in., weight — lbs./ft. Wall thickness or gauge No. SDR 26
TYPE OF SCREEN OR PERFORATION MATERIAL: (7 PVC) 10 Asbestos-cement
1 Steel 3 Stainless steel 5 Fiberglass 8 RMP (SR) 11 Other (specify)
2 Brass 4 Galvanized steel 6 Concrete tile 9 ABS 12 None used (open hole)
SCREEN OR PERFORATION OPENINGS ARE: 5 Gauzed wrapped 8 Saw cut 11 None (open hole)
1 Continuous slot (3 Mill slot) .030 6 Wire wrapped 9 Drilled holes
2 Louvered shutter 4 Key punched 7 Torch cut 10 Other (specify) ft.
SCREEN-PERFORATED INTERVALS: From 85 ft. to 105 ft., From — ft. to — ft.
From 20 ft. to 30 ft., From — ft. to — ft.
GRAVEL PACK INTERVALS: From 18 ft. to 105 ft., From — ft. to — ft.
From — ft. to — ft., From — ft. to — ft.

6 GROUT MATERIAL: 1 Neat cement 2 Cement grout (3 Bentonite) 4 Other
Grout Intervals: From 0 ft. to 18 ft., From — ft. to — ft., From — ft. to — ft.
What is the nearest source of possible contamination: 10 Livestock pens 14 Abandoned water well
1 Septic tank 4 Lateral lines 7 Pit privy 11 Fuel storage 15 Oil well/Gas well
2 Sewer lines 5 Cess pool 8 Sewage lagoon 12 Fertilizer storage 16 Other (specify below)
3 Watertight sewer lines 6 Seepage pit 9 Feedyard 13 Insecticide storage NEW SEPTIC
Direction from well? How many feet? NO CONTAMINATION PROBLEM

FROM	TO	LITHOLOGIC LOG	FROM	TO	PLUGGING INTERVALS
0	22	CLAY			
22	31	SHALE, GRAY			
31	37	SHALE, RED			
37	70	SHALE, BROWN TO RED BROWN			
70	70.5	SANDSTONE			
70.5	77	SHALE, GRAY			
77	79	LIMESTONE TAN			
79	105	SHALE, GRAY			
	105	TOTAL DEPTH			

7 CONTRACTOR'S OR LANDOWNER'S CERTIFICATION: This water well was (1) constructed, (2) reconstructed, or (3) plugged under my jurisdiction and was completed on (mo/day/year) 5/25/00 and this record is true to the best of my knowledge and belief. Kansas Water Well Contractor's Licence No. 585 This Water Well Record was completed on (mo/day/yr) 6/14/00
under the business name of ASSOC. ENVIRONMENTAL INC. by (signature) [signature]

INSTRUCTIONS: Use typewriter or ball point pen. *PLEASE PRESS FIRMLY* and *PRINT* clearly. Please fill in blanks, underline or circle the correct answers. Send top three copies to Kansas Department of Health and Environment, Bureau of Water, Topeka, Kansas 66620-0001. Telephone 785-296-5524. Send one to WATER WELL OWNER and retain one for your records. Fee of $5.00 for each constructed well.