WATER WELL RECORD Form WWC-5 KSA 82a-1212

1 LOCATION OF WATER WELL: County: Washington	Fraction: NE ¼ NW ¼ NW ¼	Section Number: 29	Township Number: T 5 S	Range Number: R 3 (E/W)

Distance and direction from nearest town or city street address of well if located within city?
Palmer is located NW 3-4 miles

2 WATER WELL OWNER: Doug Bott
RR#, St. Address, Box # : 486 Indian Road
City, State, ZIP Code : Palmer, KS 66962-8719

Board of Agriculture, Division of Water Resources
Application Number:

3 LOCATE WELL'S LOCATION WITH AN "X" IN SECTION BOX:

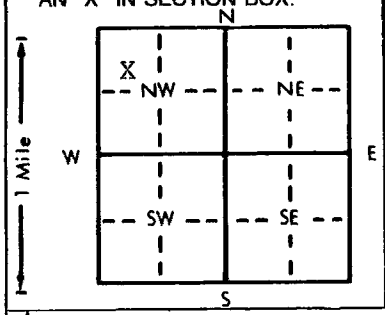

4 DEPTH OF COMPLETED WELL 21½ ft. ELEVATION:
Depth(s) Groundwater Encountered 1. — ft. 2. — ft. 3. — ft.
WELL'S STATIC WATER LEVEL 6½ ft. below land surface measured on mo/day/yr
Pump test data: Well water was NA ft. after hours pumping gpm
Est. Yield gpm: Well water was NA ft. after hours pumping gpm
Bore Hole Diameter in. to NA ft., and in. to ft.
WELL WATER TO BE USED AS: (1) 5 Public water supply 8 Air conditioning 11 Injection well
1 Domestic 3 Feedlot 6 Oil field water supply 9 Dewatering 12 Other (Specify below) Livestock
2 Irrigation 4 Industrial 7 Lawn and garden only 10 Monitoring well
Was a chemical/bacteriological sample submitted to Department? Yes No ✓; If yes, mo/day/yr sample was submitted
Water Well Disinfected? Yes ✓ No

5 TYPE OF BLANK CASING USED: 5 Wrought iron 8 Concrete tile CASING JOINTS: Glued Clamped
1 Steel 3 RMP (SR) 6 Asbestos-Cement 9 Other (specify below) Rock - Hand dug Welded
2 PVC 4 ABS 7 Fiberglass Threaded
Blank casing diameter 60" NA in. to ft., Dia in. to ft., Dia in. to ft.
Casing height above land surface NA in., weight lbs./ft. Wall thickness or gauge No.
TYPE OF SCREEN OR PERFORATION MATERIAL: NA 7 PVC 10 Asbestos-cement
1 Steel 3 Stainless steel 5 Fiberglass 8 RMP (SR) 11 Other (specify)
2 Brass 4 Galvanized steel 6 Concrete tile 9 ABS 12 None used (open hole)
SCREEN OR PERFORATION OPENINGS ARE: NA 5 Gauzed wrapped 8 Saw cut 11 None (open hole)
1 Continuous slot 3 Mill slot 6 Wire wrapped 9 Drilled holes
2 Louvered shutter 4 Key punched 7 Torch cut 10 Other (specify)
SCREEN-PERFORATED INTERVALS: From NA ft. to ft., From ft. to ft.
From ft. to ft., From ft. to ft.
GRAVEL PACK INTERVALS: From ft. to ft., From ft. to ft.
From ft. to ft., From ft. to ft.

6 GROUT MATERIAL: 1 Neat cement 2 Cement grout 3 Bentonite 4 Other
Grout Intervals: From 5 ft. to 4½ ft., From ft. to ft., From ft. to ft.
What is the nearest source of possible contamination:
1 Septic tank 4 Lateral lines 7 Pit privy 10 Livestock pens 14 Abandoned water well
2 Sewer lines 5 Cess pool 8 Sewage lagoon 11 Fuel storage 15 Oil well/Gas well
3 Watertight sewer lines 6 Seepage pit 9 Feedyard 12 Fertilizer storage 16 Other (specify below)
13 Insecticide storage
Direction from well? 400 West How many feet? Highway - insecticide use

FROM	TO	LITHOLOGIC LOG	FROM	TO	PLUGGING INTERVALS
			21½	6½	Chlorinated Sand
			6½	5	Subsoil
			5	4½	Bentonite plug
			4½	0	topsoil

7 CONTRACTOR'S OR LANDOWNER'S CERTIFICATION: This water well was (1) constructed, (2) reconstructed, or (3) plugged under my jurisdiction and was completed on (mo/day/year) 03/31/98 and this record is true to the best of my knowledge and belief. Kansas Water Well Contractor's License No. landowner This Water Well Record was completed on (mo/day/yr) 04/01/98 under the business name of Washington County Conservation District by (signature) Marlene Stamm, NPS Coordinator

INSTRUCTIONS: Use typewriter or ball point pen. *PLEASE PRESS FIRMLY* and *PRINT* clearly. Please fill in blanks, underline or circle the correct answers. Send top three copies to Kansas Department of Health and Environment, Bureau of Water, Topeka, Kansas 66620-0001. Telephone: 913-296-5545. Send one to WATER WELL OWNER and retain one for your records.

OFFICE USE ONLY T R E/W SEC. ¼ ¼ ¼