

County: Washington Fraction: SE, NW, NE, NE Sec. 24 T. 5 S R. 5 E

CORRECTION(S) to WATER WELL COMPLETION RECORD Form WWC-5 (to rectify lacking or incorrect information)

Owner: William Wrobleski Household

If location corrected, was listed as:

Section-Township-Range: _____

Fraction (¼ calls): NE, SW, NE

Location changed to:

SE, NW, NE, NE

Other changes: Initial statements: _____

Changed to: _____

Comments: Quarter fractions represented by lat/long coordinates did not match quarter fractions reported.

Verification method: Confirmed w/ Eric Strader that lat/long are correct & quarter fractions need revision.

Also used Google Earth, and STR finder.

Initials: BA Date: 10/4/2022

Submitted by: Kansas Geological Survey, Data Resources Library, 1930 Constant Ave., Lawrence, KS 66047-3724

Kansas Dept. of Health & Environment, Bureau of Water, 1000 SW Jackson, Suite 420, Topeka, KS 66612-1367

WATER WELL RECORD Form WWC-5


Original Record Correction Change in Well Use

Division of Water Resources App. No.

Well ID

1 LOCATION OF WATER WELL: County: WASHINGTON	Fraction ¼ NE ¼ SW ¼ NE ¼	Section Number 24	Township Number T 5 S	Range Number R 5 <input checked="" type="checkbox"/> E <input type="checkbox"/> W
--	------------------------------	----------------------	--------------------------	--

2 WELL OWNER: Last Name: WROBLESKI First: WILLIAM
 Business: _____
 Address: 151 SHOTWELL ROAD
 Address: _____
 City: NEWTON State: NJ ZIP: 07860
 Street or Rural Address where well is located (if unknown, distance and direction from nearest town or intersection): If at owner's address, check here:
 3/4 MILE NORTH OF COUNTY LINE ROAD AND 2ND ROAD

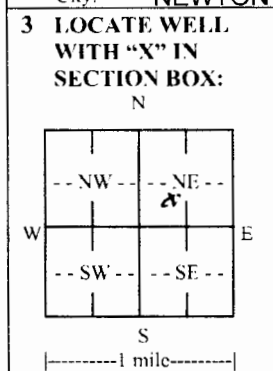

4 DEPTH OF COMPLETED WELL: 102 ft.
 Depth(s) Groundwater Encountered: 1) ft.
 2) ft. 3) ft., or 4) Dry Well
 WELL'S STATIC WATER LEVEL: 64 ft.
 below land surface, measured on (mo-day-yr) 12/24/2021
 above land surface, measured on (mo-day-yr)
 Pump test data: Well water was ft.
 after hours pumping gpm
 Well water was ft.
 after hours pumping gpm
 Estimated Yield: 15 gpm
 Bore Hole Diameter: 8 in. to 102 ft. and
 in. to ft.

5 Latitude: 39.608104 (decimal degrees)
Longitude: 96.809456 (decimal degrees)
 Horizontal Datum: WGS 84 NAD 83 NAD 27
 Source for Latitude/Longitude:
 GPS (unit make/model:)
 (WAAS enabled? Yes No)
 Land Survey Topographic Map
 Online Mapper: **GOOGLE EARTH**

6 Elevation: ft. Ground Level TOC
 Source: Land Survey GPS Topographic Map
 Other

7 WELL WATER TO BE USED AS:

1. Domestic: <input checked="" type="checkbox"/> Household <input type="checkbox"/> Lawn & Garden <input type="checkbox"/> Livestock 2. <input type="checkbox"/> Irrigation 3. <input type="checkbox"/> Feedlot 4. <input type="checkbox"/> Industrial	5. <input type="checkbox"/> Public Water Supply: well ID 6. <input type="checkbox"/> Dewatering: how many wells? 7. <input type="checkbox"/> Aquifer Recharge: well ID 8. <input type="checkbox"/> Monitoring: well ID 9. Environmental Remediation: well ID <input type="checkbox"/> Air Sparge <input type="checkbox"/> Soil Vapor Extraction <input type="checkbox"/> Recovery <input type="checkbox"/> Injection	10. <input type="checkbox"/> Oil Field Water Supply: lease 11. Test Hole: well ID <input type="checkbox"/> Cased <input type="checkbox"/> Uncased <input type="checkbox"/> Geotechnical 12. Geothermal: how many bores? a) Closed Loop <input type="checkbox"/> Horizontal <input type="checkbox"/> Vertical b) Open Loop <input type="checkbox"/> Surface Discharge <input type="checkbox"/> Inj. of Water 13. <input type="checkbox"/> Other (specify):
--	--	---

Was a chemical/bacteriological sample submitted to KDHE? Yes No If yes, date sample was submitted:
 Water well disinfected? Yes No

8 TYPE OF CASING USED: Steel PVC Other CASING JOINTS: Glued Clamped Welded Threaded
 Casing diameter 5 in. to 82 ft., Diameter in. to ft., Diameter in. to ft.
 Casing height above land surface 18 in. Weight 2.8 lbs./ft. Wall thickness or gauge No. 265
TYPE OF SCREEN OR PERFORATION MATERIAL:
 Steel Stainless Steel Fiberglass PVC Other (Specify)
 Brass Galvanized Steel Concrete tile None used (open hole)
SCREEN OR PERFORATION OPENINGS ARE:
 Continuous Slot Mill Slot Gauze Wrapped Torch Cut Drilled Holes Other (Specify)
 Louvered Shutter Key Punched Wire Wrapped Saw Cut None (Open Hole)
SCREEN-PERFORATED INTERVALS: From 82 ft. to 102 ft., From ft. to ft., From ft. to ft.
GRAVEL PACK INTERVALS: From 70 ft. to 102 ft., From ft. to ft., From ft. to ft.

9 GROUT MATERIAL: Neat cement Cement grout Bentonite Other
 Grout Intervals: From 5 ft. to 25 ft., From 65 ft. to 70 ft., From ft. to ft.
Nearest source of possible contamination:
 Septic Tank Lateral Lines Pit Privy Livestock Pens Insecticide Storage
 Sewer Lines Cess Pool Sewage Lagoon Fuel Storage Abandoned Water Well
 Watertight Sewer Lines Seepage Pit Feedyard Fertilizer Storage Oil Well/Gas Well
 Other (Specify) **NONE PRESENT**
 Direction from well? Distance from well? ft.

10 FROM	TO	LITHOLOGIC LOG	FROM	TO	LITHO. LOG (cont.) or PLUGGING INTERVALS
0	6	BROWN CLAY			
6	33	LIMESTONE & YELLOW SHALE			
33	52	RED SHALE			
52	85	YELLOW SHALE & LIMESTONE			
85	89	RED SHALE			
89	95	LIMESTONE			
95	102	RED SHALE			
			Notes:		

11 CONTRACTOR'S OR LANDOWNER'S CERTIFICATION: This water well was constructed, reconstructed, or plugged under my jurisdiction and was completed on (mo-day-year) 12/24/2021 and this record is true to the best of my knowledge and belief. Kansas Water Well Contractor's License No. 518 This Water Well Record was completed on (mo-day-year) 1/4/2022 under the business name of **BLUE VALLEY DRILLING INC.** Signature _____