USE TYPEWRITER OR BALL POINT PEN-PRESS FIRMLY, PRINT CLEARLY.

WATER WELL RECORD
KSA 82a-1201-1215

Kansas Department of Health and Environment-Division of Environment
(Water well Contractors)
Topeka, Kansas 66620

1. Location of well: County: Washington | Fraction: SE 1/4 NW 1/4 NW 1/4 | Section number: 8 | Township number: T 5 S | Range number: R 5 E E/W

2. Distance and direction from nearest town or city: 5 mi South & 1/4 Southeast of Barnes 1½ W

Street address of well location if in city:

3. Owner of well: Frank Weiche
R.R. or street:
City, state, zip code: Barnes Kans

4. Locate with "X" in section below:

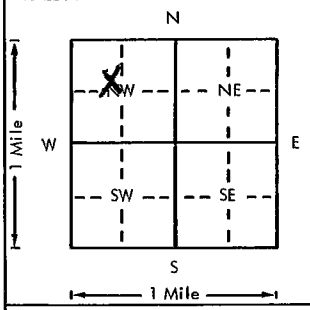

Sketch map:

6. Bore hole dia. 10 in. Completion date 12-15-78
Well depth 190 ft.

7. X Cable tool __ Rotary __ Driven __ Dug
__ Hollow rod __ Jetted __ Bored __ Reverse rotary

8. Use: X Domestic __ Public supply __ Industry
__ Irrigation __ Air conditioning __ Stock
__ Lawn __ Oil field water __ Other

9. Casing: Material PVC | Height: Above or below
Threaded __ Welded __ | Surface 14 in.
RMP __ PVC X | Weight __ lbs./ft.
Dia. 5 in. to 190 ft. depth | Wall Thickness: inches or 2.67 Wall
Dia. __ in. to __ ft. depth | gage No.

10. Screen: Manufacturer's name M.P.I.
Type P.V.C. Dia. 5"
Slot/gauge .040 Length 40'
Set between 150 ft. and 190 ft.
__ ft. and __ ft.
Gravel pack? X Size range of material ⅛ X 1/4

11. Static water level: mo./day/yr.
150 ft. below land surface Date 12-15-78

12. Pumping level below land surfaces:
__ ft. after __ hrs. pumping __ g.p.m.
__ ft. after __ hrs. pumping __ g.p.m.
Estimated maximum yield 12 g.p.m.

13. Water sample submitted: mo./day/yr.
__ Yes X No Date

14. Well head completion: NA
__ Pitless adapter __ Inches above grade

15. Well grouted? X 1-2
With: __ Neat cement __ Bentonite X Concrete
Depth: From 15 ft. to 5 ft.

16. Nearest source of possible contamination:
ft. 70 Direction NORTH Type old Well
Well disinfected upon completion? X Yes __ No

17. Pump: X Not installed
Manufacturer's name
Model number HP Volts
Length of drop pipe ft. capacity g.p.m.
Type:
__ Submersible __ Turbine
__ Jet __ Reciprocating
__ Centrifugal __ Other

5. Type and color of material	From	To
top soil, Black	0	2
Sand stone, Red	2	42
Clay yellow	42	47
Shale, Blue	47	50
Rock, yellow-Lime	50	70
Shale, Red	70	90
Rock, yellow lime	90	105
Shale, Blue	105	110
Shale, Red	110	155
Rock yellow lime (Water)	155	165
Shale Red	165	190

(Use a second sheet if needed)

18. Elevation: 1410'
Topography:
X Hill
__ Slope
__ Upland
__ Valley

19. Remarks:

20. Water well contractor's certification:
This well was drilled under my jurisdiction and this report is true to the best of my knowledge and belief.
Strader Drilling Co. 137
Business name License No.
Address Blue Rapids
Signed Harold Strader Date 12-19-78
Authorized representative

T 5 S R 5 E W Sec 8 SE NW NW 1/4 1/4 1/4

Forward the white, blue and pink copies to the Department of Health and Environment

Form WWC-5

MI-1023