


LOCATION OF WATER WELL: County: Marshall Fraction: SE 1/4 SE 1/4 SW 1/4 Section Number: 21 Township Number: T 5 S Range Number: R 6 E/W

Distance and direction from nearest town or city Street address of well if located within city? Waterville 6 1/2 miles South + 1/2 mi west on north side road

WATER WELL OWNER: Francis Dobrowolny Board of Agriculture, Division of Water Resources
 RR#, St. Address, Box # R1 Waterville Kans 66548 Application Number:

LOCATE WELL'S LOCATION WITH AN "X" IN SECTION BOX:

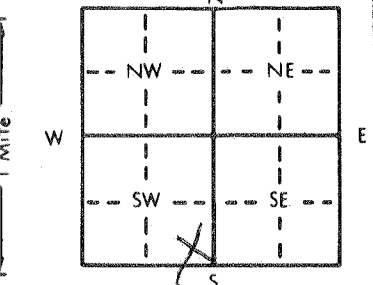

DEPTH OF COMPLETED WELL: 103 ft. ELEVATION: _____

Depth(s) Groundwater Encountered 1. 70 ft. 2. _____ ft. 3. _____ ft.

WELL'S STATIC WATER LEVEL: 65 ft. below land surface measured on mo/day/yr Sept 30, 1981

Pump test data: Well water was _____ ft. after _____ hours pumping _____ gpm

Est. Yield 20 gpm: Well water was _____ ft. after _____ hours pumping _____ gpm

Bore Hole Diameter: 1.0 in. to 1.5 ft., and 6 1/2 in. to 1.03 ft.

WELL WATER TO BE USED AS: 5 Public water supply 8 Air conditioning 11 Injection well
 1 Domestic 3 Feedlot 6 Oil field water supply 9 Dewatering 12 Other (Specify below)
 2 Irrigation 4 Industrial 7 Lawn and garden only 10 Observation well

Was a chemical/bacteriological sample submitted to Department? Yes _____ No X If yes, mo/day/yr sample was submitted _____

Water Well Disinfected? Yes X No _____

TYPE OF BLANK CASING USED: 1 Steel 3 RMP (SR) 5 Wrought iron 8 Concrete tile CASING JOINTS: Glued X Clamped _____
 2 PVC 4 ABS 6 Asbestos-Cement 9 Other (specify below) Welded _____
 7 Fiberglass Threaded _____

Blank casing diameter 5 in. to 1.03 ft., Dia _____ in. to _____ ft., Dia _____ in. to _____ ft.

Casing height above land surface 2.4 in., weight _____ lbs./ft. Wall thickness or gauge No. 2.67 Wall

TYPE OF SCREEN OR PERFORATION MATERIAL: 1 Steel 3 Stainless steel 5 Fiberglass 8 RMP (SR) 11 Other (specify) _____
 2 Brass 4 Galvanized steel 6 Concrete tile 9 ABS 12 None used (open hole)

SCREEN OR PERFORATION OPENINGS ARE: 5 Gauzed wrapped 8 Saw cut 11 None (open hole)
 1 Continuous slot 3 Mill slot 6 Wire wrapped 9 Drilled holes
 2 Louvered shutter 4 Key punched 7 Torch cut 10 Other (specify) _____

SCREEN-PERFORATED INTERVALS: From 1.03 ft. to 63 ft., From _____ ft. to _____ ft.
 From _____ ft. to _____ ft., From _____ ft. to _____ ft.

GRAVEL PACK INTERVALS: From 1.03 ft. to 1.5 ft., From _____ ft. to _____ ft.
 From _____ ft. to _____ ft., From _____ ft. to _____ ft.

GROUT MATERIAL: 1 Neat cement 2 Cement grout 3 Bentonite 4 Other _____
 Grout Intervals: From 7 ft. to 14 ft., From _____ ft. to _____ ft., From _____ ft. to _____ ft.

What is the nearest source of possible contamination: 1 Septic tank 4 Lateral lines 7 Pit privy 11 Fuel storage 14 Abandoned water well
 2 Sewer lines 5 Cess pool 8 Sewage lagoon 12 Fertilizer storage 15 Oil well/Gas well
 3 Watertight sewer lines 6 Seepage pit 9 Feedyard 13 Insecticide storage 16 Other (specify below)

Direction from well? South How many feet? 95 away from house roof

FROM	TO	LITHOLOGIC LOG	FROM	TO	LITHOLOGIC LOG
0	4	top soil			
4	28	clay, yellow			
28	38	clay, Red & sticky			
38	97	yellow, Rock line & water at 70'			
97	103	Rock, Real hard, Blue			

CONTRACTOR'S OR LANDOWNER'S CERTIFICATION: This water well was (1) constructed (2) reconstructed, or (3) plugged under my jurisdiction and was completed on (mo/day/year) Sept 30, 1981 and this record is true to the best of my knowledge and belief. Kansas Water Well Contractor's License No. 137 This Water Well Record was completed on (mo/day/yr) Oct 1, 1981

under the business name of Strader Drilling Co by (signature) Harold Strader

INSTRUCTIONS: Use typewriter or ball point pen, PLEASE PRESS FIRMLY and PRINT clearly. Please fill in blanks, underline or circle the correct answers. Send top three copies to Kansas Department of Health and Environment, Division of Environment, Environmental Geology Section, Topeka, KS 66620. Send one to WATER WELL OWNER and retain one for your records.