


T. J. Cole

1 LOCATION OF WATER WELL: County: Marshall Fraction: SE 1/4 SE 1/4 SE 1/4 Section Number: 31 Township Number: T 5 S Range Number: R 7 E/W

Distance and direction from nearest town or city street address of well if located within city? 7 miles south of Blue Rapids on Blacktop road west side

2 WATER WELL OWNER: Alfred Pushney RR#, St. Address, Box #: Blue Rapids Kang, 66411 Board of Agriculture, Division of Water Resources Application Number:

3 LOCATE WELL'S LOCATION WITH AN "X" IN SECTION BOX:

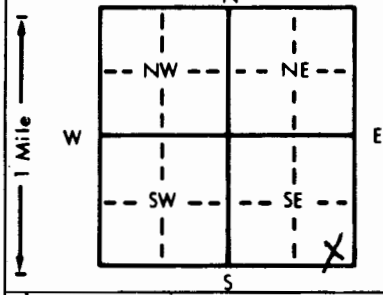

4 DEPTH OF COMPLETED WELL: 90 ft. ELEVATION: no water ft. 2. just a test ft. high

Depth(s) Groundwater Encountered 1. no water ft. 2. just a test ft. high

WELL'S STATIC WATER LEVEL none ft. below land surface measured on mo/day/yr dec 8 - 81

Pump test data: Well water was none ft. after none hours pumping none gpm

Est. Yield none gpm; Well water was none ft. after none hours pumping none gpm

Bore Hole Diameter: 10 in. to none ft., and none in. to none ft.

WELL WATER TO BE USED AS: 5 Public water supply 8 Air conditioning 11 Injection well

1 Domestic 3 Feedlot 6 Oil field water supply 9 Dewatering 12 Other (Specify below)

2 Irrigation 4 Industrial 7 Lawn and garden only 10 Observation well

Was a chemical/bacteriological sample submitted to Department? Yes.....No.....; If yes, mo/day/yr sample was submitted

Water Well Disinfected? Yes No

5 TYPE OF BLANK CASING USED: 1 Steel 3 RMP (SR) no casing 5 Wrought iron 8 Concrete tile CASING JOINTS: Glued.....Clamped.....

2 PVC 4 ABS 7 Fiberglass 9 Other (specify below) Welded.....

Blank casing diameter .....in. to .....ft., Dia .....in. to .....ft., Dia .....in. to .....ft.

Casing height above land surface .....in., weight ..... lbs./ft. Wall thickness or gauge No. ....

TYPE OF SCREEN OR PERFORATION MATERIAL: 1 Steel 3 Stainless steel 5 Fiberglass 7 PVC 10 Asbestos-cement

2 Brass 4 Galvanized steel 6 Concrete tile 8 RMP (SR) 11 Other (specify) .....

SCREEN OR PERFORATION OPENINGS ARE: 1 Continuous slot 3 Mill slot 5 Gauzed wrapped 8 Saw cut 11 None (open hole)

2 Louvered shutter 4 Key punched 6 Wire wrapped 9 Drilled holes

3 Torch cut 10 Other (specify) .....

SCREEN-PERFORATED INTERVALS: From ..... ft. to ..... ft., From ..... ft. to ..... ft.

GRAVEL PACK INTERVALS: From ..... ft. to ..... ft., From ..... ft. to ..... ft.

6 GROUT MATERIAL: 1 Neat cement 2 Cement grout 3 Bentonite 4 Other .....

Grout Intervals: From ..... ft. to ..... ft., From ..... ft. to ..... ft., From ..... ft. to ..... ft.

What is the nearest source of possible contamination: 1 Septic tank 4 Lateral lines 7 Pit privy 10 Livestock pens 14 Abandoned water well

2 Sewer lines 5 Cess pool 8 Sewage lagoon 11 Fuel storage 15 Oil well/Gas well

3 Watertight sewer lines 6 Seepage pit 9 Feedyard 12 Fertilizer storage 16 Other (specify below)

13 Insecticide storage

Direction from well? How many feet?

FROM	TO	LITHOLOGIC LOG	FROM	TO	LITHOLOGIC LOG
0	3	top soil			
3	10	clay red			
10	19	Rock, limestone			
19	40	clay, yellow			
40	55	Rock, limestone			
55	90	Blue shale, Hard			
90	96	Plugged with clay to 13 ft of top + the 10 ft cement and 3 ft soil on top			

7 CONTRACTOR'S OR LANDOWNER'S CERTIFICATION: This water well was (1) constructed, (2) reconstructed, or (3) plugged under my jurisdiction and was completed on (mo/day/year) dec 8 - 1981 and this record is true to the best of my knowledge and belief. Kansas

Water Well Contractor's License No. 237 This Water Well Record was completed on (mo/day/yr) Dec 10 - 81

under the business name of Strader Drilling Co by (signature) Harold Strader

INSTRUCTIONS: Use typewriter or ball point pen, PLEASE PRESS FIRMLY and PRINT clearly. Please fill in blanks, underline or circle the correct answers. Send top