


1 LOCATION OF WATER WELL: Fraction SW¹/₄ SW¹/₄ NW¹/₄ Section Number 24 Township Number 6 Range Number 1 EW
 County: Clay

Distance and direction from nearest town or city street address of well if located within city?
3 to 3 1/2 miles South of Clifton - East side of highway

2 WATER WELL OWNER: Mark Taddiken
 RR #, St. Address, Box #: 2614 Hackberry Rd
 City, State, ZIP Code: Clifton, KS 66937 Board of Agriculture, Division of Water Resources
 Application Number: _____

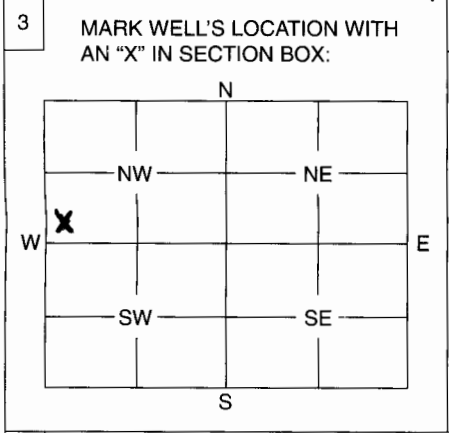

4 DEPTH OF WELL 54 ft.
 WELL'S STATIC WATER LEVEL 20 ft.
 WELL WAS USED AS:
 1 Domestic 5 Public Water Supply 9 Dewatering
 2 Irrigation 6 Oil Field Water Supply 10 Monitoring Well
 3 Feedlot 7 Domestic (Lawn & Garden) 11 Injection Well
 4 Industrial 8 Air Conditioning 12 Other

Was a chemical / bacteriological sample submitted to Department? Yes No
 If yes, mo/day/yr sample was submitted N/A

Water Well Disinfected: Yes No

5 TYPE OF BLANK CASING USED:
 1 Steel 3 RMP (SR) 5 Wrought 7 Fiberglass 9 Other (Specify below)
 2 PVC 4 ABS 6 Asbestos-Cement 8 Concrete Tile

Blank casing diameter 6" in. Was casing pulled? Yes No
 Casing height above or below land surface 4' in. If yes, how much

6 GROUT PLUG MATERIAL: 1 Neat cement 2 Cement grout 3 Bentonite 4 Other

Grout Plug Intervals: From 24 ft. to 4 ft., From ft. to ft., From to ft.

What is the nearest source of possible contamination:
 1 Septic tank 6 Seepage pit 11 Fuel storage 16 Other (specify below)
 2 Sewer lines 7 Pit privy 12 Fertilizer storage

Direction from well? How many feet?

FROM	TO	PLUGGING MATERIALS
54	24	sand & gravel
24	4	bentonite
4	0	TOP SOIL

7 CONTRACTOR'S OF LANDOWNER'S CERTIFICATION: This water well was plugged under my jurisdiction and was completed on (mo/day/year) 06/07/2006 and this record is true to the best of my knowledge and belief. Kansas Water Well Contractor's License No. 6-47 This Water Well Record was completed on (mo/day/year) 6-9-06 under the business name of MEL'S PUMP & PLUMBING by (signature) Melvin M Anderson

INSTRUCTIONS: Use typewriter or ball point pen. Please press firmly and print clearly. Please fill in blanks, underline or circle the correct answers. Send top three copies to Kansas Department of Health and Environment, Bureau of Water, Geology Section, 1000 SW Jackson St., Ste. 420, Topeka, Kansas 66612-1367. Telephone: 785/296-5522. Send one to Water Well Owner and retain one for your records.