

County: Clay Fraction: NE NW NW NE Sec. 2 T. 6 S R. 1 E

CORRECTION(S) to WATER WELL COMPLETION RECORD Form WWC-5 (to rectify lacking or incorrect information)

Owner: Kramer, Chad

If location corrected, was listed as:

Location changed to:

Section-Township-Range: _____

Fraction (1/4 calls): _____

Other changes: Initial statements: Checker said Clay; originally entered as Washington.

Changed to: _____

Comments: _____

Verification method: KGS Mapper used to check well's location against county line.

Initials: BK Date: 6-15-2021

Submitted by: ☒ Kansas Geological Survey, Data Resources Library, 1930 Constant Ave., Lawrence, KS 66047-3724
☐ Kansas Dept. of Health & Environment, Bureau of Water, 1000 SW Jackson, Suite 420, Topeka, KS 66612-1367


MW9

Well ID

Visit us at <http://www.kdheks.gov/waterwell/index.html>

KSA 82a-1212

Revised 7/10/2015

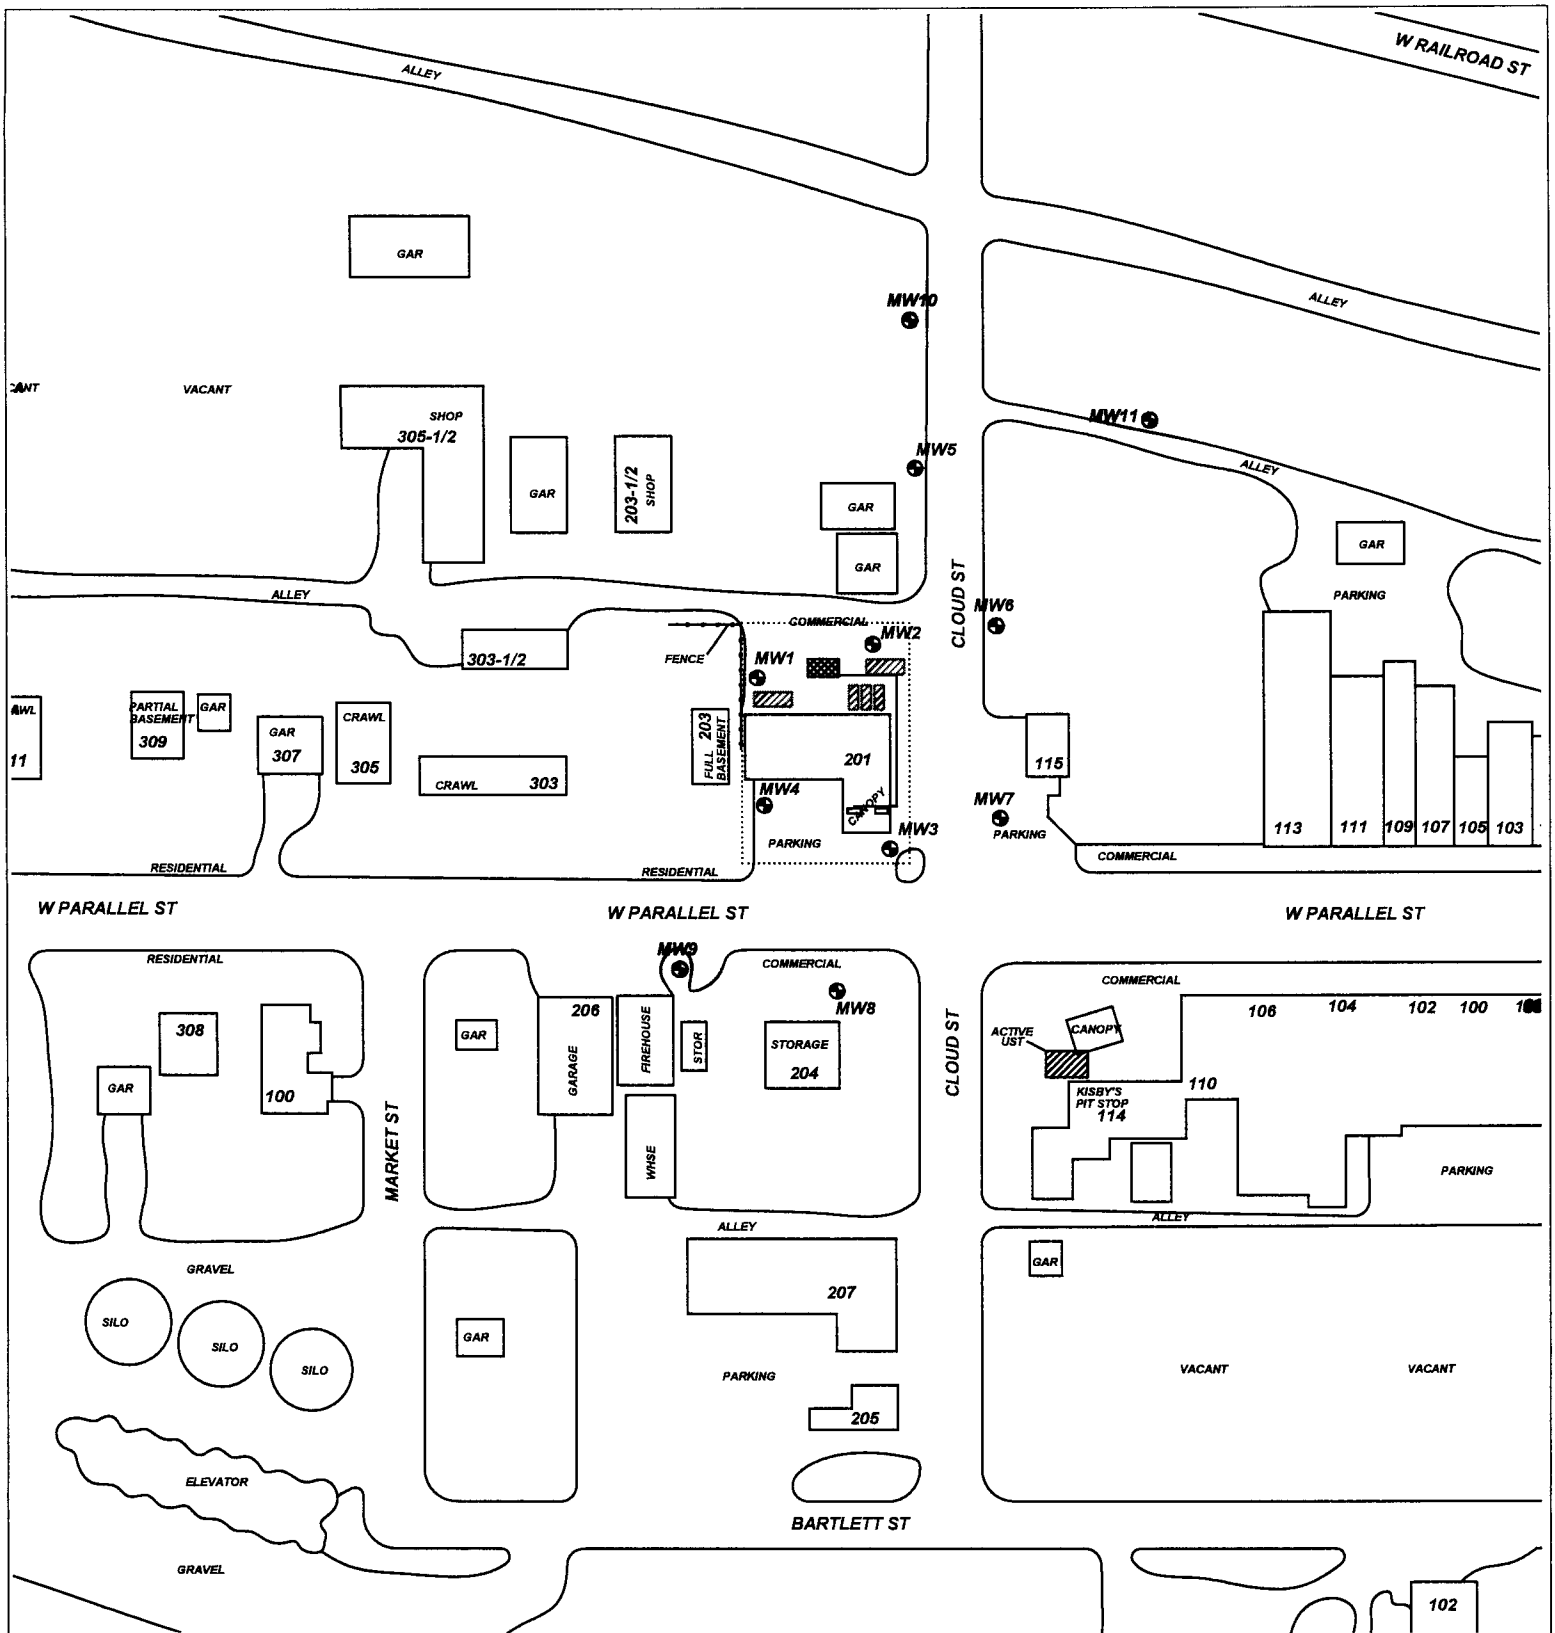

PROJECT: **CLIFTON CARDLOCK**

ADDRESS: **201 W. PARALLEL ST.**

LOCATION: **CLIFTON, KS**

DRAWN BY: **C. ROE** DATE: **1/15/20**

REVISED BY: **B. STALNAKER** DATE: **3/24/21**

AEI JOB #: **TF521** KDHE JOB #: **U5-101-15172**

TITLE: **FIGURE 2.1
AREA BASE MAP
350' RADIUS**

**ASSOCIATED
ENVIRONMENTAL
INC.**

LEGEND:

- = FORMER USTS
- = ACTIVE AST, FUEL LINES AND PUMP ISLANDS
- = MONITORING WELL

..... = SUBJECT PROPERTY

RECEIVED

APR 09 2021

BUREAU OF WATER

SCALE: **1" = 100'**

NOTES: