
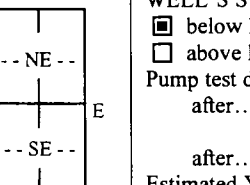


☒ Original Record    ☐ Correction    ☐ Change in Well Use

Resources App. No.

Well ID

<b>1 LOCATION OF WATER WELL:</b> County: Washington		Fraction NE ¼ NW ¼ NW ¼ NE ¼	Section Number <b>2</b>	Township Number T 6 S	Range Number R 1 E W
<b>2 WELL OWNER:</b> Last Name: Kramer First: Chad Business: Kramer Oil Co., Inc. Address: PO Box 343 City: Marysville State: KS ZIP: 66508		Street or Rural Address where well is located (if unknown, distance and direction from nearest town or intersection): If at owner's address, check here: <input type="checkbox"/> <b>204 E Parallel St</b> <b>Clifton, KS 66937</b>			
<b>3 LOCATE WELL WITH "X" IN SECTION BOX:</b> N  S ----- 1 mile -----	<b>4 DEPTH OF COMPLETED WELL:</b> ..... 25 ..... ft. Depth(s) Groundwater Encountered: 1) ..... 17 ..... ft. 2) ..... ft. 3) ..... ft. or 4) <input type="checkbox"/> Dry Well WELL'S STATIC WATER LEVEL: ..... ft. <input checked="" type="checkbox"/> below land surface, measured on (mo-day-yr) ..... 6/23/21 ..... <input type="checkbox"/> above land surface, measured on (mo-day-yr) ..... Pump test data: Well water was ..... ft. after ..... hours pumping ..... gpm Well water was ..... ft. after ..... hours pumping ..... gpm Estimated Yield: ..... gpm Bore Hole Diameter: ..... 8.5 ..... in. to ..... 25 ..... ft. and ..... in. to ..... ft.		<b>5 Latitude:</b> ..... 39.56630 ..... (decimal degrees) <b>Longitude:</b> ..... 97.28204 ..... (decimal degrees) Horizontal Datum: <input type="checkbox"/> WGS 84 <input checked="" type="checkbox"/> NAD 83 <input type="checkbox"/> NAD 27 Source for Latitude/Longitude: <input type="checkbox"/> GPS (unit make/model: ..... ) (WAAS enabled? <input type="checkbox"/> Yes <input type="checkbox"/> No) <input checked="" type="checkbox"/> Land Survey <input type="checkbox"/> Topographic Map <input type="checkbox"/> Online Mapper: .....		
	<b>6 Elevation:</b> ..... 1270.62 ..... ft. <input type="checkbox"/> Ground Level <input checked="" type="checkbox"/> TOC Source: <input checked="" type="checkbox"/> Land Survey <input type="checkbox"/> GPS <input type="checkbox"/> Topographic Map <input type="checkbox"/> Other .....				
<b>7 WELL WATER TO BE USED AS:</b> 1. Domestic: <input type="checkbox"/> Household <input type="checkbox"/> Lawn & Garden <input type="checkbox"/> Livestock <input type="checkbox"/> Irrigation 2. Feedlot <input type="checkbox"/> Industrial 3. Public Water Supply: well ID ..... 4. Dewatering: how many wells? ..... 5. Aquifer Recharge: well ID ..... 6. Monitoring: well ID ..... MW12 7. Environmental Remediation: well ID ..... <input type="checkbox"/> Air Sparge <input type="checkbox"/> Soil Vapor Extraction <input type="checkbox"/> Recovery <input type="checkbox"/> Injection 8. Oil Field Water Supply: lease ..... 9. Test Hole: well ID ..... <input type="checkbox"/> Cased <input type="checkbox"/> Uncased <input type="checkbox"/> Geotechnical 10. Geothermal: how many bores? ..... a) Closed Loop <input type="checkbox"/> Horizontal <input type="checkbox"/> Vertical b) Open Loop <input type="checkbox"/> Surface Discharge <input type="checkbox"/> Inj. of Water 11. Other (specify): .....					
<b>Was a chemical/bacteriological sample submitted to KDHE?</b> <input type="checkbox"/> Yes <input checked="" type="checkbox"/> No If yes, date sample was submitted: ..... Water well disinfected? <input type="checkbox"/> Yes <input checked="" type="checkbox"/> No					
<b>8 TYPE OF CASING USED:</b> <input type="checkbox"/> Steel <input checked="" type="checkbox"/> PVC <input type="checkbox"/> Other ..... CASING JOINTS: <input type="checkbox"/> Glued <input type="checkbox"/> Clamped <input type="checkbox"/> Welded <input checked="" type="checkbox"/> Threaded Casing diameter ..... 2 ..... in. to ..... 25 ..... ft., Diameter ..... in. to ..... ft., Diameter ..... in. to ..... ft. Casing height above land surface ..... in. Weight ..... lbs./ft. Wall thickness or gauge No. 40 ..... <b>TYPE OF SCREEN OR PERFORATION MATERIAL:</b> <input type="checkbox"/> Steel <input type="checkbox"/> Stainless Steel <input type="checkbox"/> Fiberglass <input checked="" type="checkbox"/> PVC <input type="checkbox"/> Other (Specify) ..... <input type="checkbox"/> Brass <input type="checkbox"/> Galvanized Steel <input type="checkbox"/> Concrete tile <input type="checkbox"/> None used (open hole) <b>SCREEN OR PERFORATION OPENINGS ARE:</b> <input type="checkbox"/> Continuous Slot <input checked="" type="checkbox"/> Mill Slot <input type="checkbox"/> Gauze Wrapped <input type="checkbox"/> Torch Cut <input type="checkbox"/> Drilled Holes <input type="checkbox"/> Other (Specify) ..... <input type="checkbox"/> Louvered Shutter <input type="checkbox"/> Key Punched <input type="checkbox"/> Wire Wrapped <input type="checkbox"/> Saw Cut <input type="checkbox"/> None (Open Hole) <b>SCREEN-PERFORATED INTERVALS:</b> From ..... 15 ..... ft. to ..... 25 ..... ft., From ..... ft. to ..... ft., From ..... ft. to ..... ft. <b>GRAVEL PACK INTERVALS:</b> From ..... 13 ..... ft. to ..... 25 ..... ft., From ..... ft. to ..... ft., From ..... ft. to ..... ft.					
<b>9 GROUT MATERIAL:</b> <input type="checkbox"/> Neat cement <input type="checkbox"/> Cement grout <input checked="" type="checkbox"/> Bentonite <input type="checkbox"/> Other ..... 0-1 Concrete Grout Intervals: From ..... 1 ..... ft. to ..... 13 ..... ft., From ..... ft. to ..... ft., From ..... ft. to ..... ft. <b>Nearest source of possible contamination:</b> <input type="checkbox"/> Septic Tank <input type="checkbox"/> Lateral Lines <input type="checkbox"/> Pit Privy <input type="checkbox"/> Livestock Pens <input type="checkbox"/> Insecticide Storage <input type="checkbox"/> Sewer Lines <input type="checkbox"/> Cess Pool <input type="checkbox"/> Sewage Lagoon <input checked="" type="checkbox"/> Fuel Storage <input type="checkbox"/> Abandoned Water Well <input type="checkbox"/> Watertight Sewer Lines <input type="checkbox"/> Seepage Pit <input type="checkbox"/> Feedyard <input type="checkbox"/> Fertilizer Storage <input type="checkbox"/> Oil Well/Gas Well <input type="checkbox"/> Other (Specify) ..... Direction from well? Northwest Distance from well? 280 ..... ft.					
<b>10 FROM TO LITHOLOGIC LOG</b> 0 1 Topsoil, silty clay loam 1 25 Silty clay		<b>FROM TO LITHO. LOG (cont.) or PLUGGING INTERVALS</b>           Notes: Clifton Cardlock U5-101-15172 Clifton, KS 66937			
<b>11 CONTRACTOR'S OR LANDOWNER'S CERTIFICATION:</b> This water well was <input checked="" type="checkbox"/> constructed, <input type="checkbox"/> reconstructed, or <input type="checkbox"/> plugged under my jurisdiction and was completed on (mo-day-year) 6/22/21 ..... and this record is true to the best of my knowledge and belief. Kansas Water Well Contractor's License No. 585 This Water Well Record was completed on (mo-day-year) 7/11/21 ..... under the business name of Associated Environmental, Inc. Signature _____ Mail 1 white copy along with a fee of \$5.00 for each constructed well to: Kansas Department of Health and Environment, Bureau of Water, GWTS Section, 1000 SW Jackson St., Suite 420, Topeka, Kansas 66612-1367. Mail one to Water Well Owner and retain one for your records. Telephone 785-296-5524. Visit us at http://www.kdheks.gov/waterwell/index.html KSA 82a-1212 Revised 7/10/2015					

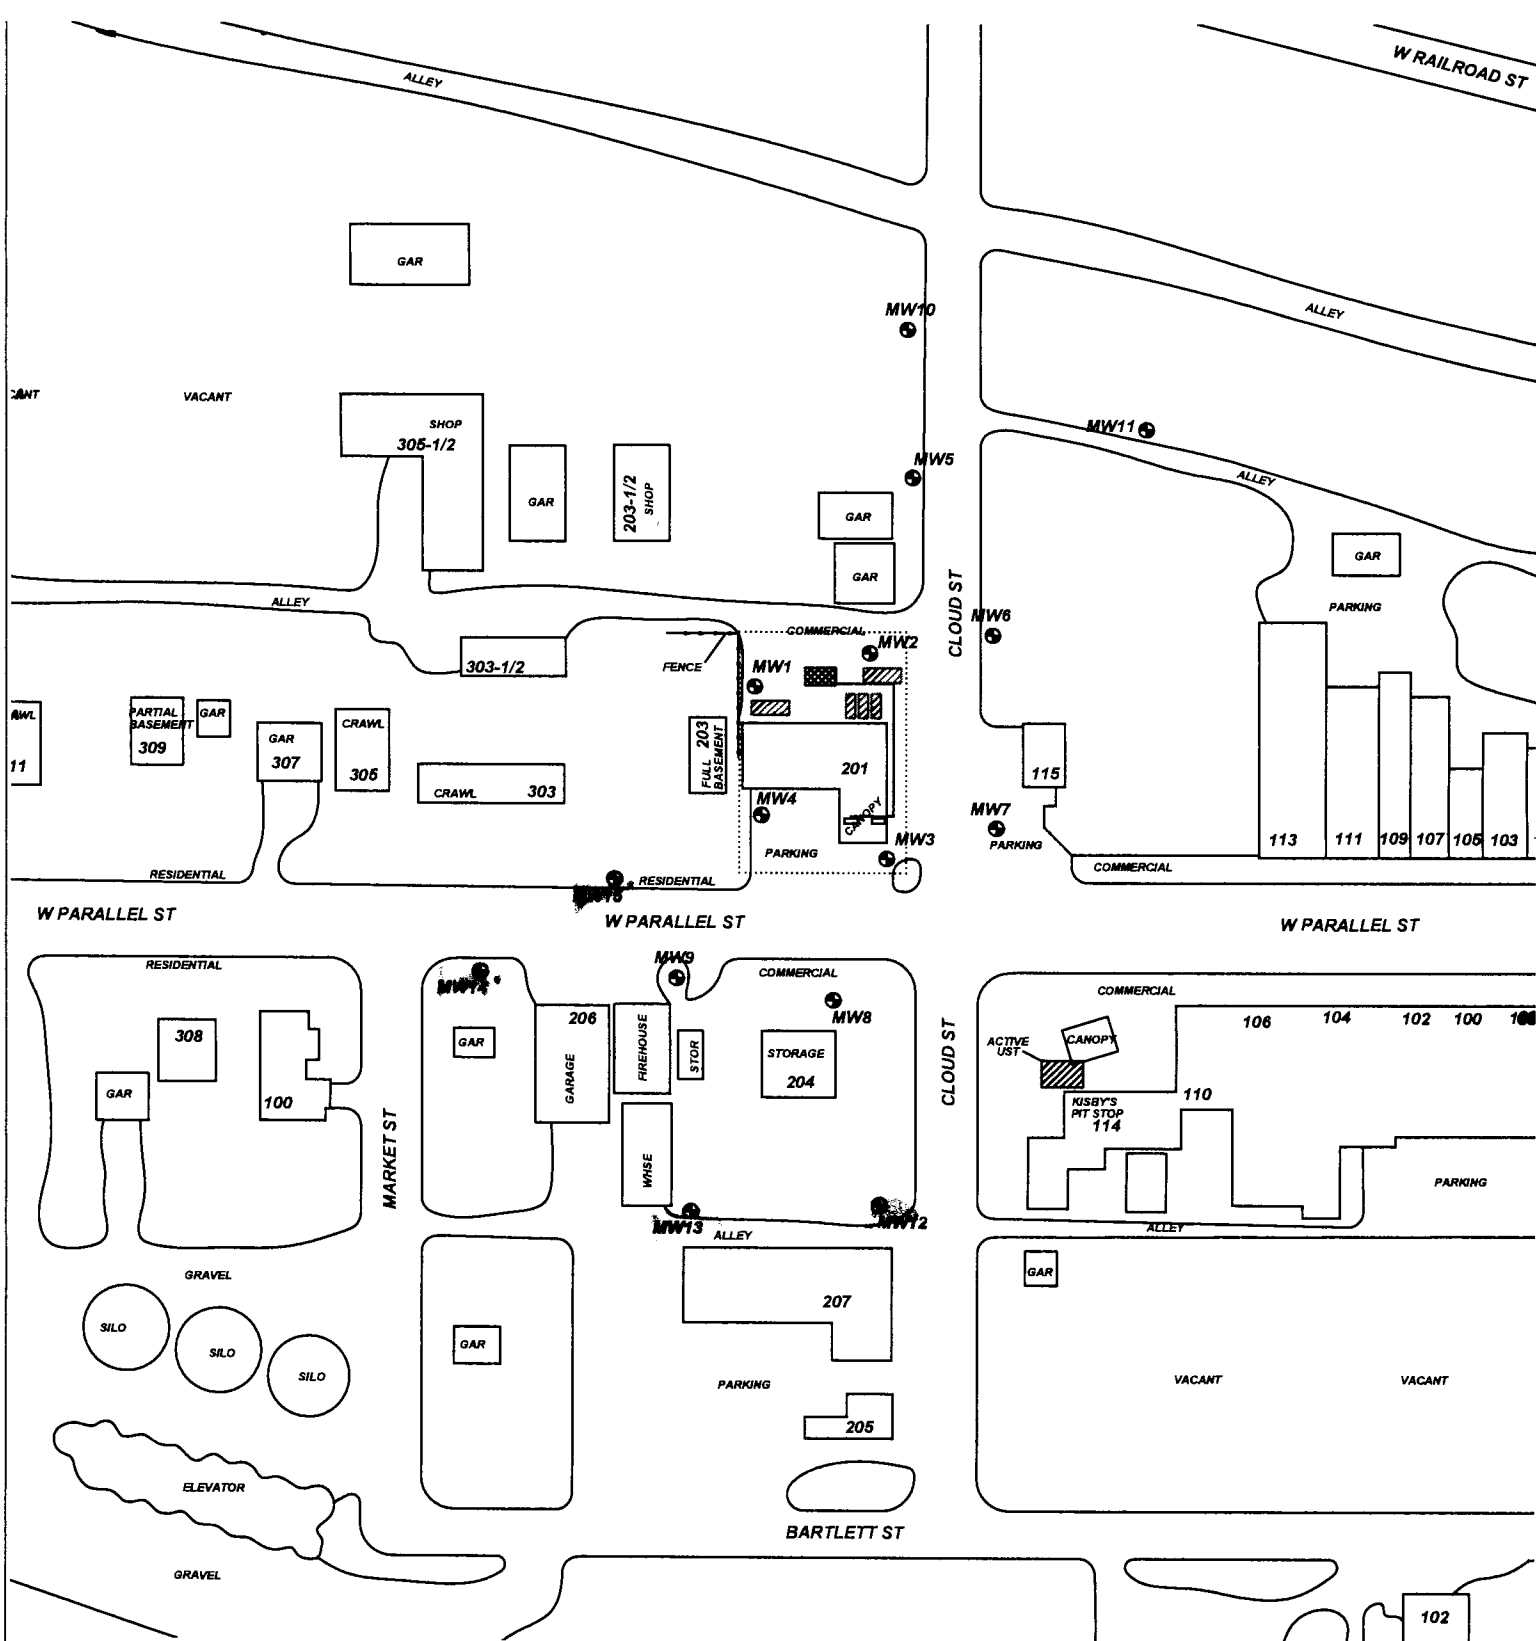

PROJECT: **CLIFTON CARDLOCK**

ADDRESS: **201 W. PARALLEL ST.**

LOCATION: **CLIFTON, KS**

DRAWN BY: **C. ROE** DATE: **1/15/20**

REVISED BY: **B. STALNAKER** DATE: **7/19/21**

AE JOB #: **TF521** KDHE JOB #: **U5-101-15172**

TITLE: **FIGURE 2.1  
AREA BASE MAP  
350' RADIUS**

**AE** **ASSOCIATED  
ENVIRONMENTAL  
INC.**

LEGEND:

= FORMER USTS

= ACTIVE AST, FUEL LINES AND PUMP ISLANDS

= MONITORING WELL

..... = SUBJECT PROPERTY

SCALE: **1" = 100'**

NOTES: